



FALL CREEK REGIONAL WASTE DISTRICT

9378 S. 650 West PO Box 59
Pendleton, IN 46064-0059 778-7544

26-00048.00

add order
on file

APPLICATION FOR SEWER PERMIT

No 2811

Date 6-16-2000

Permit Void 90 days from Date of Issuance

Owner Name Jeff McKinney

Property Address 6739 S. 600 W.

Lot #

P.O. Box

Town Pendleton

IN Zip Code 46064

Phone

City Water

Well

\$ 2556.00

Tap on Fee Paid 8/7/00

grinder unit paid for
by M.E.M. Excavating

\$ Inspection fee paid

Application is hereby made for connection to the Fall Creek Regional Waste District Sewer System for the above listed property - Permit Type: Residential ☒, Commercial ☐, Industrial ☐, or Governmental/Institutional ☐. User Information

All workmanship and materials shall conform to the standards of the District Ordinance as described in Ordinance 84-2 and 84-3 as amended. Acceptance and approval must be made by the District inspector or his duly authorized representative before backfilling and final connection is made to the main sewer lines. Any violation of applicable regulations will cause all lines and appurtenances in violation to be removed and replaced at the owners expense.

The Fall Creek Regional Waste District is responsible for the inspection, approval of materials, and installation techniques only. All costs for materials and installation and any liabilities resulting from same is the sole responsibility of the property owner.

I have read and fully understand the above provisions and agree to comply by said provisions.

APPLICANT(S) SIGNATURE

INSPECTOR Ben

Date inspected 6-21-00

Approved ☒

Rejected ☐

Reason for rejection

Date reinspected

Approved ☐

Rejected ☐

Notes:

Size Pipe 4" "

Type Pipe PVC

Basement Yes No ☒

Sump Pump Yes No ☒

Downspout to Ground Yes ☒ No


Septic Tank Pumped & filled Yes No ☒

Contractor M3M Exc.

Special Conditions

Existing Home

New Construction ☒

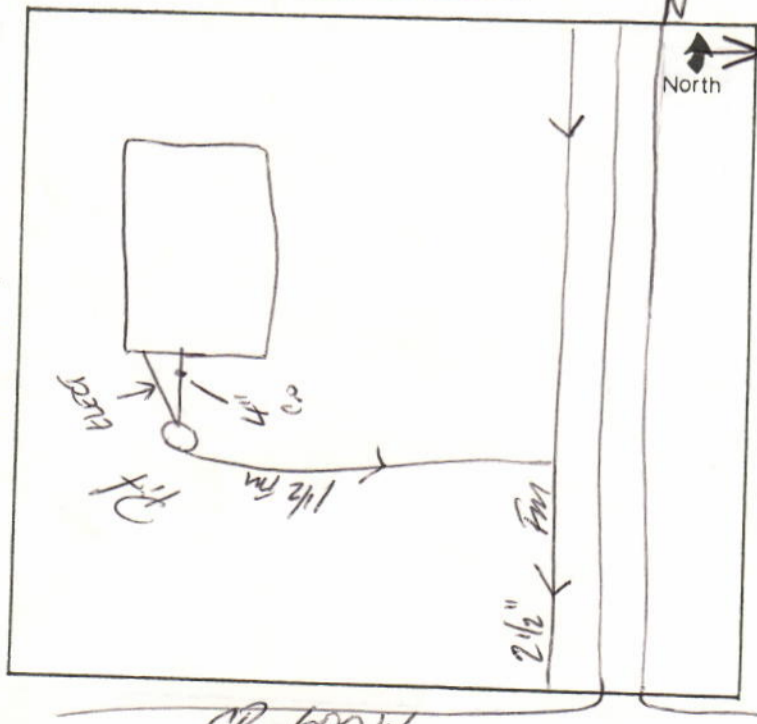

JEFF OR JILL McKINNEY 11/95
PH. 765-778-2302
501 N. PENDLETON AVE.
PENDLETON, IN 46064

20-7043/2740

3447

Date... 7 Aug 00

Pay to the order of F.C.R.W.D. \$ 2,556

TWO THOUSAND FIVE HUNDRED FIFTY SIX ^{00/100} ~~Dollars~~

FIRST INDIANA BANK
INDIANAPOLIS, IN 46204

—EARTH MATTERS—

For _____

Jim AM/K

⑆274070439⑆

47

RAINFORESTS ARE ESSENTIAL TO THE GLOBAL ENVIRONMENT