

Gidw.

PROJECT Phase II SHEET _____ OF _____


SUBJECT _____ DATE 6-18-18

JOB NO. 4447

BY Atlas

677 S. Pendleton

← N

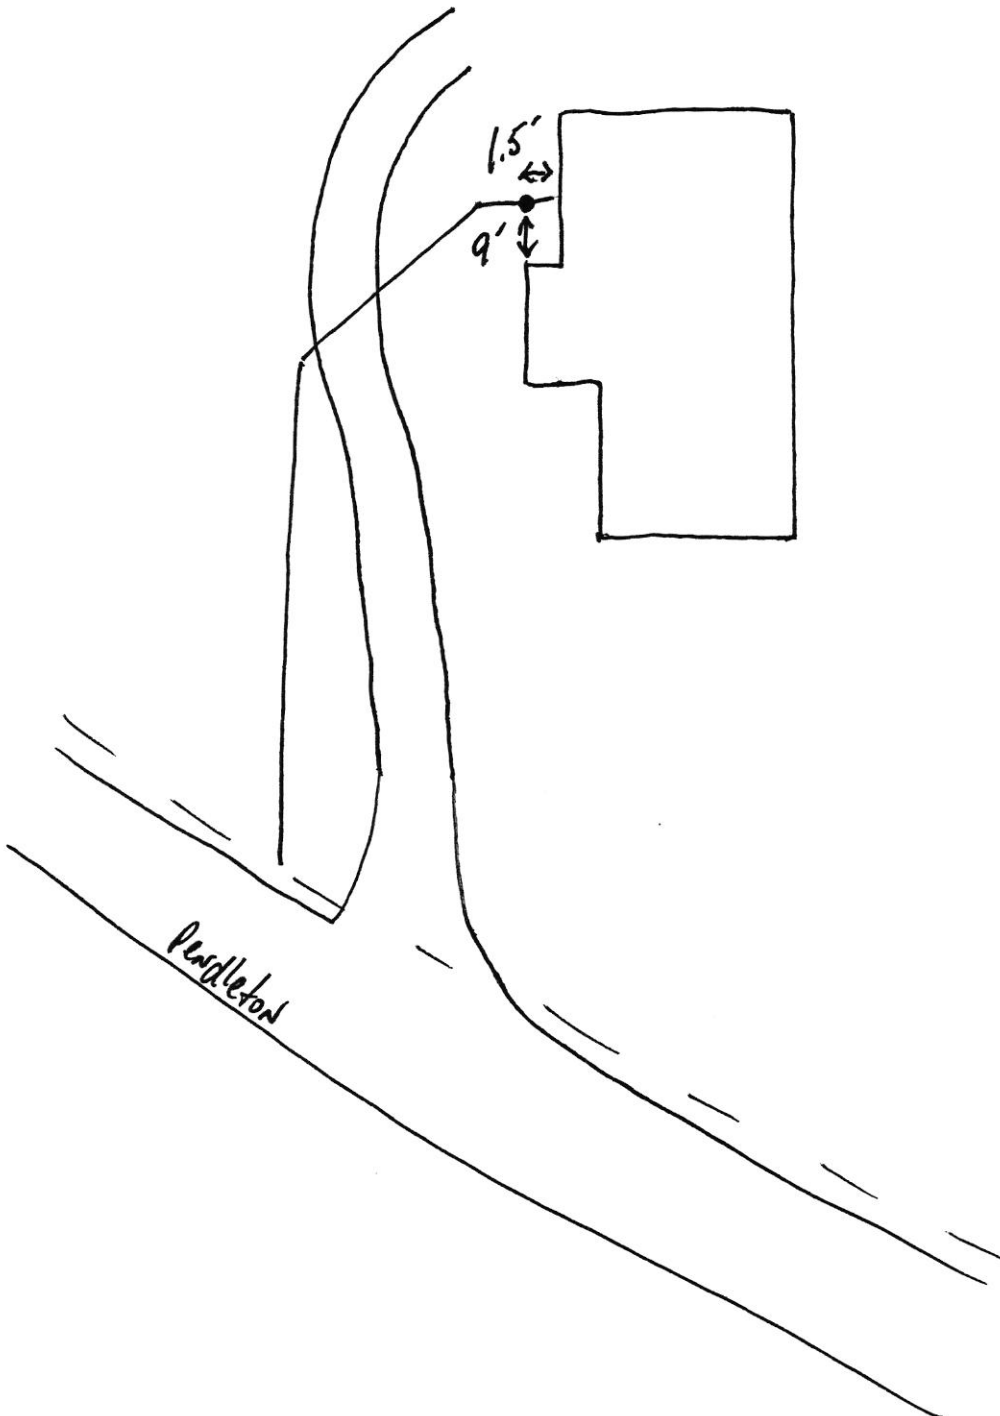

101 S Rendleton Ave

SRF Phase II

10.19.18

