

add order
on file



FALL CREEK REGIONAL WASTE DISTRICT

9378 S. 650 West PO Box 59
Pendleton, IN 46064-0059 778-7544

Campbell Custom Homes Inc

26-08010.00

APPLICATION FOR SEWER PERMIT

No 2747

Date 4/6/00

Permit Void 90 days from Date of Issuance

Owner Name Scott Campbell

Property Address 6804 S Fosters Branch Ct.

Lot # 2 Fosters Branch Woods P.O. Box

Town Pendleton, IN Zip Code 46064

Phone City Water Well

\$ 2556.00 Tap on Fee Paid
\$ Inspection fee paid paid for grinder unit 4/6/00 \$1024.80

Application is hereby made for connection to the Fall Creek Regional Waste District Sewer System for the above listed property - Permit Type: Residential, Commercial, Industrial, or Governmental/Institutional. User Information

All workmanship and materials shall conform to the standards of the District Ordinance as described in Ordinance 84-2 and 84-3 as amended. Acceptance and approval must be made by the District inspector or his duly authorized representative before backfilling and final connection is made to the main sewer lines. Any violation of applicable regulations will cause all lines and appurtenances in violation to be removed and replaced at the owners expense.

The Fall Creek Regional Waste District is responsible for the inspection, approval of materials, and installation techniques only. All costs for materials and installation and any liabilities resulting from same is the sole responsibility of the property owner.

I have read and fully understand the above provisions and agree to comply by said provisions.

APPLICANT(S) SIGNATURE

INSPECTOR

Date inspected 5/15/00 Approved Rejected

Reason for rejection

Date reinspected Approved Rejected

Notes:

Size Pipe 4"

Type Pipe SDR 35

Basement Yes No

Sump Pump Yes No

Downspout to Ground Yes No


Septic Tank Pumped & filled Yes NO

Contractor M & M

Special Conditions

Existing Home

New Construction

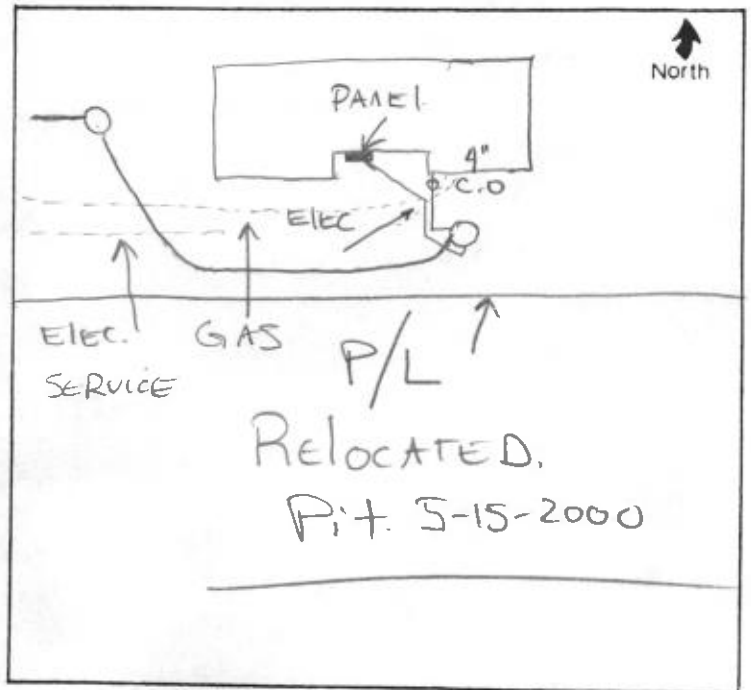

copy for [illegible]

RAIL CREEK REGIONAL WASTE DISTRICT
2125 S. 42ND STREET
TULSA, OK 74109-0025
918-482-1234



RA-08010-00

Chapman & [illegible]

NO 2147

NOTIFICATION FOR [illegible]

DATE 11/10/10

PROPERTY: 10000 S. 42ND STREET
OWNER: [illegible]
ADDRESS: 10000 S. 42ND STREET
CITY: TULSA
STATE: OK
ZIP: 74109
COUNTY: TULSA
TRACT: [illegible]
SECTION: [illegible]
TAX MAP: [illegible]
TAX ID: [illegible]


pay for [illegible]
[illegible]

NOTICE: The Rail Creek Regional Waste District is responsible for the collection, removal, and disposal of solid waste. The District is not responsible for the collection, removal, and disposal of hazardous waste. The District is not responsible for the collection, removal, and disposal of flammable, volatile, or toxic liquids. The District is not responsible for the collection, removal, and disposal of radioactive materials. The District is not responsible for the collection, removal, and disposal of explosives. The District is not responsible for the collection, removal, and disposal of other hazardous materials. The District is not responsible for the collection, removal, and disposal of other materials that are not solid waste.

The Rail Creek Regional Waste District is responsible for the collection, removal, and disposal of solid waste. The District is not responsible for the collection, removal, and disposal of hazardous waste. The District is not responsible for the collection, removal, and disposal of flammable, volatile, or toxic liquids. The District is not responsible for the collection, removal, and disposal of radioactive materials. The District is not responsible for the collection, removal, and disposal of explosives. The District is not responsible for the collection, removal, and disposal of other hazardous materials. The District is not responsible for the collection, removal, and disposal of other materials that are not solid waste.

The Rail Creek Regional Waste District is responsible for the collection, removal, and disposal of solid waste. The District is not responsible for the collection, removal, and disposal of hazardous waste. The District is not responsible for the collection, removal, and disposal of flammable, volatile, or toxic liquids. The District is not responsible for the collection, removal, and disposal of radioactive materials. The District is not responsible for the collection, removal, and disposal of explosives. The District is not responsible for the collection, removal, and disposal of other hazardous materials. The District is not responsible for the collection, removal, and disposal of other materials that are not solid waste.

RAIL CREEK REGIONAL WASTE DISTRICT
2125 S. 42ND STREET
TULSA, OK 74109-0025
918-482-1234

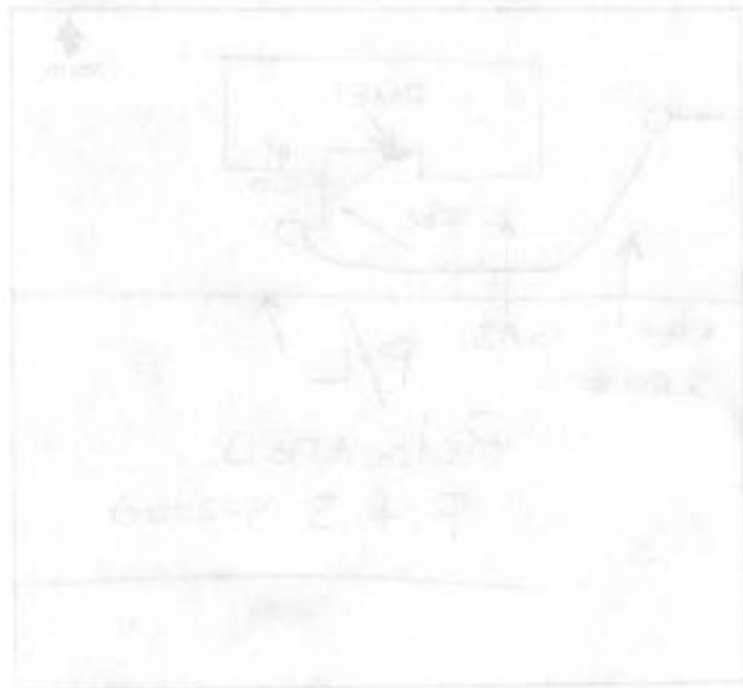

1. [illegible]
2. [illegible]
3. [illegible]
4. [illegible]
5. [illegible]
6. [illegible]
7. [illegible]
8. [illegible]
9. [illegible]
10. [illegible]