



FALL CREEK REGIONAL WASTE DISTRICT

9378 S. 650 West PO Box 59
Pendleton, IN 46064-0059 778-7544

APPLICATION FOR SEWER PERMIT

Nº 2525

Date

7/7/98

Permit Void 90 days from Date of Issuance

Owner Name

Rick Balsbaugh

Property Address

6806 S 25 E

Lot #

11

P.O. Box

Town

Pendleton

IN Zip Code

46064

Phone

City Water

Well

X

\$

725

Tap on Fee Paid

9/10/98

\$

2000

capacity inspection fee paid

9/10/98

Application is hereby made for connection to the Fall Creek Regional Waste District Sewer System for the above listed property - Permit Type: Residential ☒, Commercial ☐, Industrial ☐, or Governmental/Institutional ☐. User Information _____.

All workmanship and materials shall conform to the standards of the District Ordinance as described in Ordinance 84-2 and 84-3 as amended. Acceptance and approval must be made by the District inspector or his duly authorized representative before backfilling and final connection is made to the main sewer lines. Any violation of applicable regulations will cause all lines and appurtenances in violation to be removed and replaced at the owners expense.

The Fall Creek Regional Waste District is responsible for the inspection, approval of materials, and installation techniques only. All costs for materials and installation and any liabilities resulting from same is the sole responsibility of the property owner.

I have read and fully understand the above provisions and agree to comply by said provisions.

APPLICANT(S) SIGNATURE

INSPECTOR

Don

Date inspected

7-7-98

Approved

☒

Rejected

Reason for rejection

Date reinspected

Approved

Rejected

Notes:

Size Pipe

6

"

Type Pipe

PVC

Basement Yes

No

☒

Sump Pump Yes

No

☒

Downspout to Ground Yes

No

☒

Septic Tank Pumped & filled Yes

No

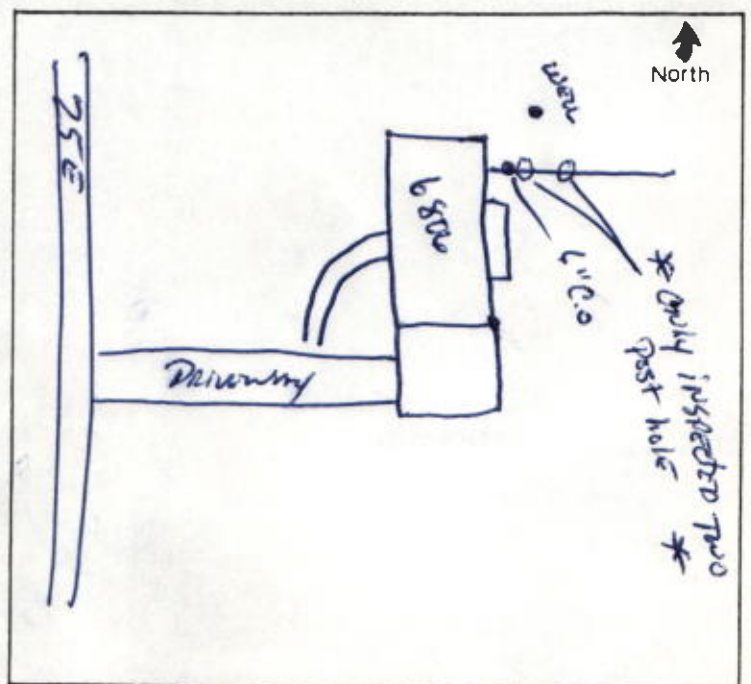
Contractor

Special Conditions

Ditch was backfilled

Existing Home

New Construction

☒

45

44-38861-1000