



FALL CREEK REGIONAL WASTE DISTRICT

9378 S. 650 West PO Box 59
Pendleton, IN 46064-0059 778-7544

22-50027.00

Nº 2107

APPLICATION FOR SEWER PERMIT

Date 6-29-94

Permit Void 90 days from Date of Issuance

Owner Name D. (amy) J. Swan

Property Address 6828 S. 25 E.

Lot # 10 P.O. Box

Town Pendleton, IN Zip Code 46064

Phone 649-6203 City Water Well

\$ 2700.00 Tap on Fee Paid

\$ 25.00 Inspection fee paid

Application is hereby made for connection to the Fall Creek Regional Waste District Sewer System for the above listed property - Permit Type: Residential, Commercial, Industrial, or Governmental/Institutional. User Information

All workmanship and materials shall conform to the standards of the District Ordinance as described in Ordinance 84-2 and 84-3 as amended. Acceptance and approval must be made by the District inspector or his duly authorized representative before backfilling and final connection is made to the main sewer lines. Any violation of applicable regulations will cause all lines and appurtenances in violation to be removed and replaced at the owners expense.

The Fall Creek Regional Waste District is responsible for the inspection, approval of materials, and installation techniques only. All costs for materials and installation and any liabilities resulting from same is the sole responsibility of the property owner.

I have read and fully understand the above provisions and agree to comply by said provisions.

Kathie Swan
APPLICANT(S) SIGNATURE

INSPECTOR TIM

Date inspected 6-29-94 Approved Rejected

Reason for rejection

Date reinspected Approved Rejected

Notes:

Size Pipe 6"

Type Pipe SDR 35

Basement Yes No

Sump Pump Yes No

Downspout to Ground Yes No


Septic Tank Pumped & filled Yes No

Contractor Jim Baker

Special Conditions

Existing Home

New Construction

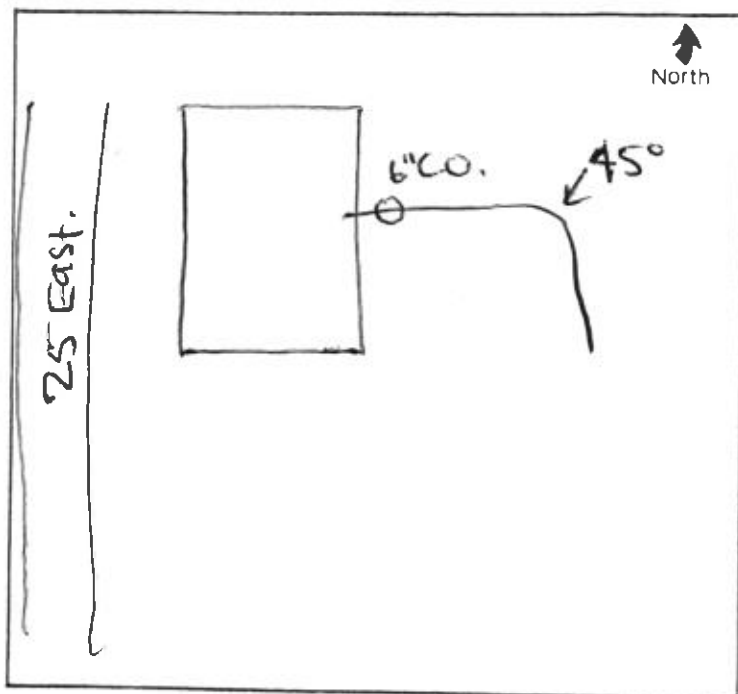

7017 2

19 32 3

Summa of 19 32 3
2 25 3 25 3

Summa of 19 32 3
2 25 3 25 3

19 32 3

19 32 3

19 32 3

19 32 3

