



FALL CREEK REGIONAL WASTE DISTRICT

9378 S. 650 West PO Box 59
Pendleton, IN 46064-0059 778-7544

add order
on file

22-23435.00

No 2712

APPLICATION FOR SEWER PERMIT

Date 10/25/99

Permit Void 90 days from Date of Issuance

Owner Name Mike Gaskill

Property Address 6838 S 50 W

Lot # _____ P.O. Box _____

Town Pendleton, IN Zip Code 46064

Phone _____ City Water _____ Well ☒

\$ 400 Tap on Fee Paid

\$ 2156 Capacity Inspection fee paid

Application is hereby made for connection to the Fall Creek Regional Waste District Sewer System for the above listed property - Permit Type: Residential ☒, Commercial _____, Industrial _____, or Governmental/Institutional _____. User Information _____.

All workmanship and materials shall conform to the standards of the District Ordinance as described in Ordinance 84-2 and 84-3 as amended. Acceptance and approval must be made by the District inspector or his duly authorized representative before backfilling and final connection is made to the main sewer lines. Any violation of applicable regulations will cause all lines and appurtenances in violation to be removed and replaced at the owners expense.

The Fall Creek Regional Waste District is responsible for the inspection, approval of materials, and installation techniques only. All costs for materials and installation and any liabilities resulting from same is the sole responsibility of the property owner.

I have read and fully understand the above provisions and agree to comply by said provisions.

APPLICANT(S) SIGNATURE

INSPECTOR BEN

Date inspected 10-25-99 Approved ☒ Rejected _____

Reason for rejection _____

Date reinspected _____ Approved _____ Rejected _____

Notes:

Size Pipe 4"

Type Pipe PVC

Basement Yes _____ No ☒

Sump Pump Yes _____ No ☒

Downspout to Ground Yes ☒ No _____


Septic Tank Pumped & filled Yes ☒ No _____

Contractor M & M

Special Conditions _____

Existing Home _____

New Construction ☒

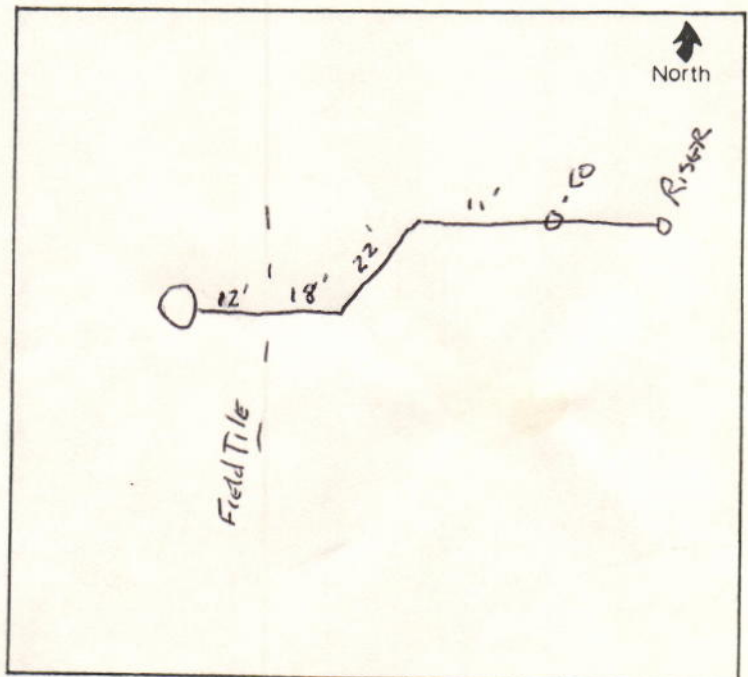

**M & M EXCAVATING**

765-778-2569 765-778-8227

3440 W 900 S

PENDLETON, IN 46064

1522

20-6/740 308

DATE 10-25-99PAY TO THE ORDER OF FAIL CREEK REGIONAL Waste District\$ 2556.00Two thousand Five Hundred fifty six and56 DOLLARS ☒ Security features included. Details on back.**National City.**National City Bank of Indiana
Anderson, IndianaFOR Graskill Tap Fee.T. McCurdy Pres.

⑈001522⑈ ⑈074000065⑈