



FALL CREEK REGIONAL WASTE DISTRICT

Box 44, Pendleton, Indiana 46064

2-0010960.00

APPLICATION FOR SEWER PERMIT

Nº 000845

Permit No. _____ Date 12-2-85

Permit Void 90 days from Date of Issuance

Owner Name Everett Plummer

Property Address 6852 Hendricks St.

Lot # _____ P.O. Box _____

Town Anderson, IN Zip Code 46013

Phone 644-3851 Water Meter _____

\$ 150.00 Tap on Fee Paid

\$ 25.00 Inspection fee paid

Application is hereby made for connection to the Fall Creek Regional Waste District Sewer System for the above listed property - Permit Type: Residential ☒, Commercial _____, Industrial _____, or Governmental/Institutional _____. User Information _____.

All workmanship and materials shall conform to the standards of the District Ordinance as described in Ordinance 84-2 and 84-3 as amended. Acceptance and approval must be made by the District inspector or his duly authorized representative before backfilling and final connection is made to the main sewer lines. Any violation of applicable regulations will cause all lines and appurtenances in violation to be removed and replaced at the owners expense.

The Fall Creek Regional Waste District is responsible for the inspection, approval of materials, and installation techniques only. All costs for materials and installation and any liabilities resulting from same is the sole responsibility of the property owner.

I have read and fully understand the above provisions and agree to comply by said provisions.


Everett Plummer
APPLICANT(S) SIGNATURE

INSPECTOR [Signature]
Date inspected 1-14 Approved _____ Rejected _____

Reason for rejection _____

Date reinspected _____ Approved _____ Rejected _____

Notes:
Size Pipe 6"
Type Pipe PVC
Basement Yes _____ No ☒
Sump Pump Yes _____ No ☒
Downspout to Ground Yes ☒ No _____
Septic Tank Pumped & filled Yes _____ No ☒
Contractor FLATFORD
Special Conditions _____

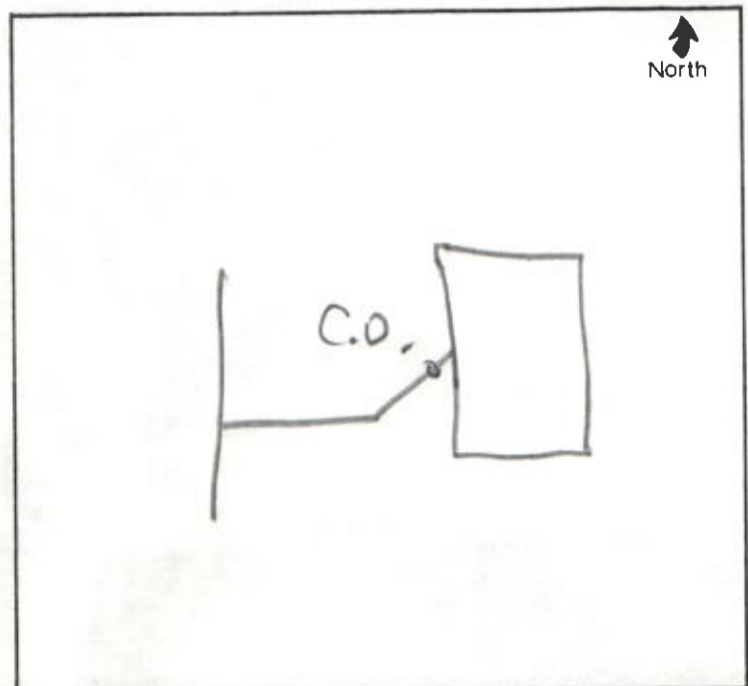

P.56



No 000245

12-8-82

Owner: Everett Plummer
Address: 6822 Kendrick St

City: Frederick
State: Idaho
Zip: 83421

Phone: 208-325-1200
Fax: 208-325-1200

Service: Water
Sewer: Yes

Notes: All water service and sewer service is provided by the City of Frederick. The City of Frederick is the only provider of water and sewer service in the City of Frederick. The City of Frederick is the only provider of water and sewer service in the City of Frederick.

Comments: The City of Frederick is the only provider of water and sewer service in the City of Frederick. The City of Frederick is the only provider of water and sewer service in the City of Frederick.

Signature: Frank Plummer

Date: 12-8-82

City: Frederick

State: Idaho

Zip: 83421

Phone: 208-325-1200

Fax: 208-325-1200

Service: Water

Sewer: Yes

