

**Fall Creek Regional Waste District**  
 9378 S 650 W, P.O. Box 59, Pendleton, IN 46064  
 765-778-7544

#7444

**Agreement for Sanitary Sewer Service**

This Agreement made and entered into this 18 day of June, 2020 between Fall Creek Regional Waste District ("District") and Arbor Homes ("Applicant") regarding the provision of sanitary sewer service, and the assignment of capacity in and connection to, the District's facilities for the premises located at Maple Trails Lot 126.

Street Address: 6860 Aster DR

**Now therefore**, the parties, in consideration of the mutual promises set out in this Agreement, the receipt and sufficiency of which is hereby acknowledged, agree as follows:

1. The Applicant agrees that all workmanship and materials shall conform to all District ordinances and the District's construction standards. District must accept and approve all work and materials before backfilling and final connection is made to the sewer mains. Any violation of this provision will cause all lines and appurtenances in violation to be removed and replaced at the Applicant's expense.
2. The District shall have the right to enter upon the Applicant's premises at all reasonable times to inspect, repair, or replace any equipment used in connection with the District's service or which has an impact on said service.
3. The Applicant shall be responsible for all monthly user rates, capacity charges, and tap fees. The failure to pay any rate charge or fee may result in a lien against the property and/or the termination of service to the property, the cost of which will be borne by Applicant, including, but not limited to, all attorney's fees and collection costs.
4. The District shall not be responsible for any damages as a result of any failure to supply service unless said damages are due to default, neglect or culpability on the part of the District.
5. If there is an available sanitary sewer within three hundred (300) feet of the property line, the property owner shall be required to connect to the District's sanitary sewer system.
6. The Applicant and District agree that the provision of sanitary sewer service touches and concerns the property and the terms of this Agreement bind the District and Applicant and their heirs, executors, administrators, personal representatives, successors, agents, attorneys, assigns, designees, and transferees.

The parties hereto have read and fully understand the above provisions and agree to comply with said provisions.

FALL CREEK REGIONAL WASTE DISTRICT

Rebecca Hunter  
Signature

APPLICANT

Ronda Ellis  
Signature

STATE OF INDIANA )  
 ) SS:  
 COUNTY OF MADISON )

SUBSCRIBED and sworn to before me this \_\_\_\_ day of \_\_\_\_\_, 20\_\_

My Commission Expires:

Signature \_\_\_\_\_

Printed \_\_\_\_\_

Notary Public

Resident of \_\_\_\_\_ County


\*\*\*\*\*


Inspector Don Date Inspected 9-16-21 Approved ✓ Rejected \_\_\_\_\_

Reason for Rejection \_\_\_\_\_  
 Date Reinspected \_\_\_\_\_ Approved \_\_\_\_\_ Rejected \_\_\_\_\_

Notes:  
 Size Pipe 6" Type Pipe PVC 35  
 Basement Yes No  
 Sump Pump Yes No  
 Downspout to Ground Yes No  
 Septic Tank Pumped & Filled Yes No  
 Contractor DR WATSON ET.  
 Special Conditions \_\_\_\_\_  
 Existing Home \_\_\_\_\_  
 New Construction ✓

Property Connection  
reinstalled & inspected  
by Kyle 10-6-2021

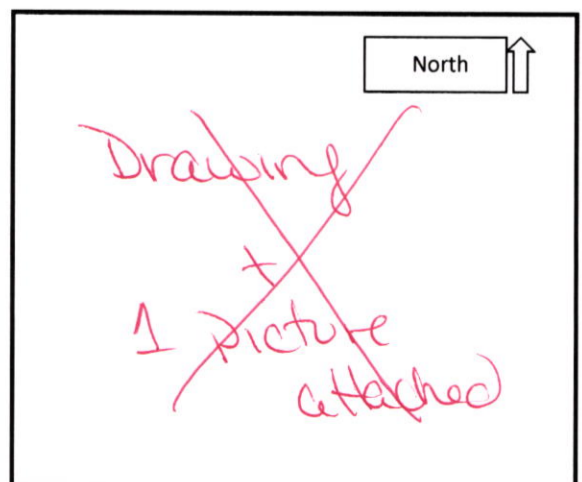


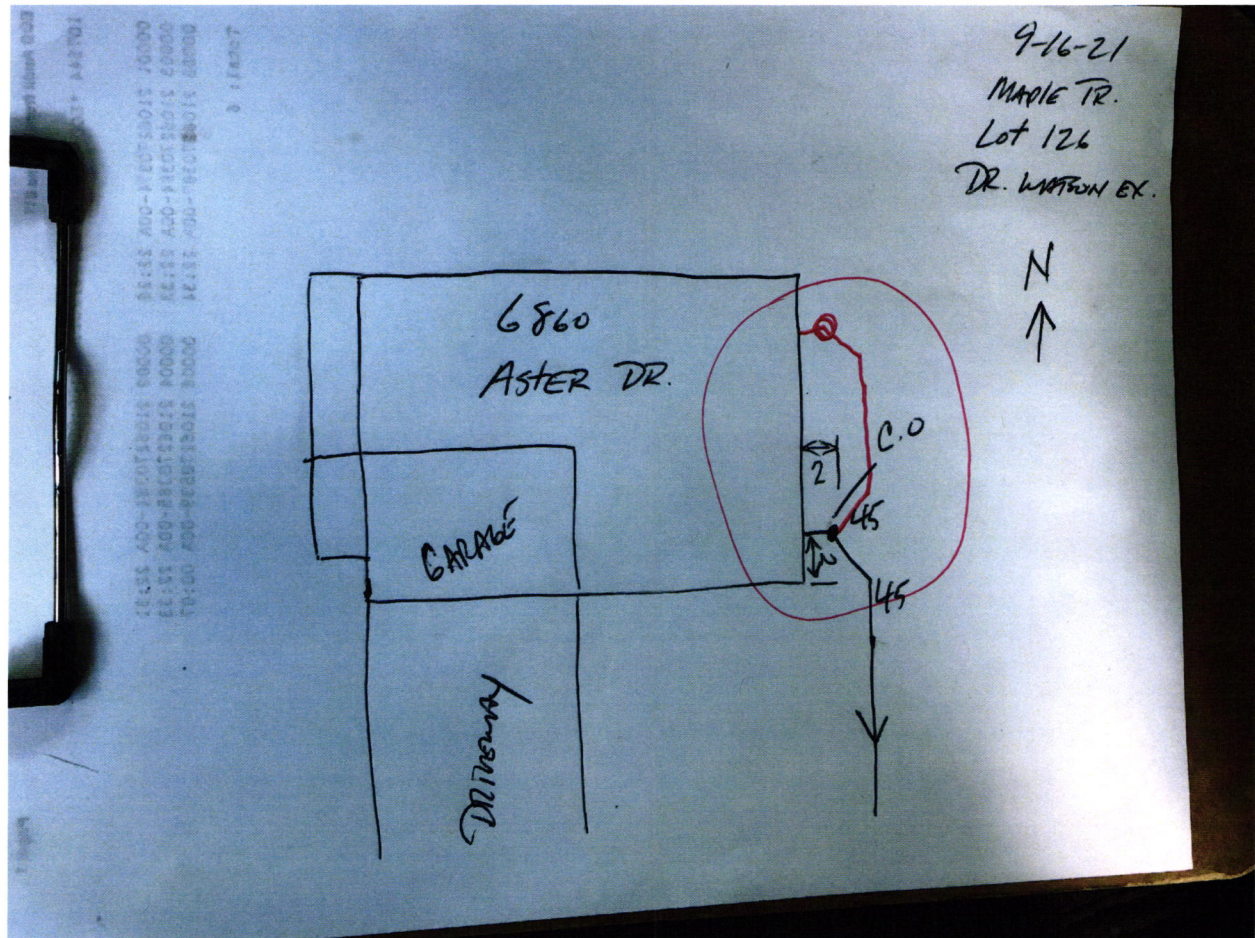

Kyle 10.6.21



Kyle 10-6-21

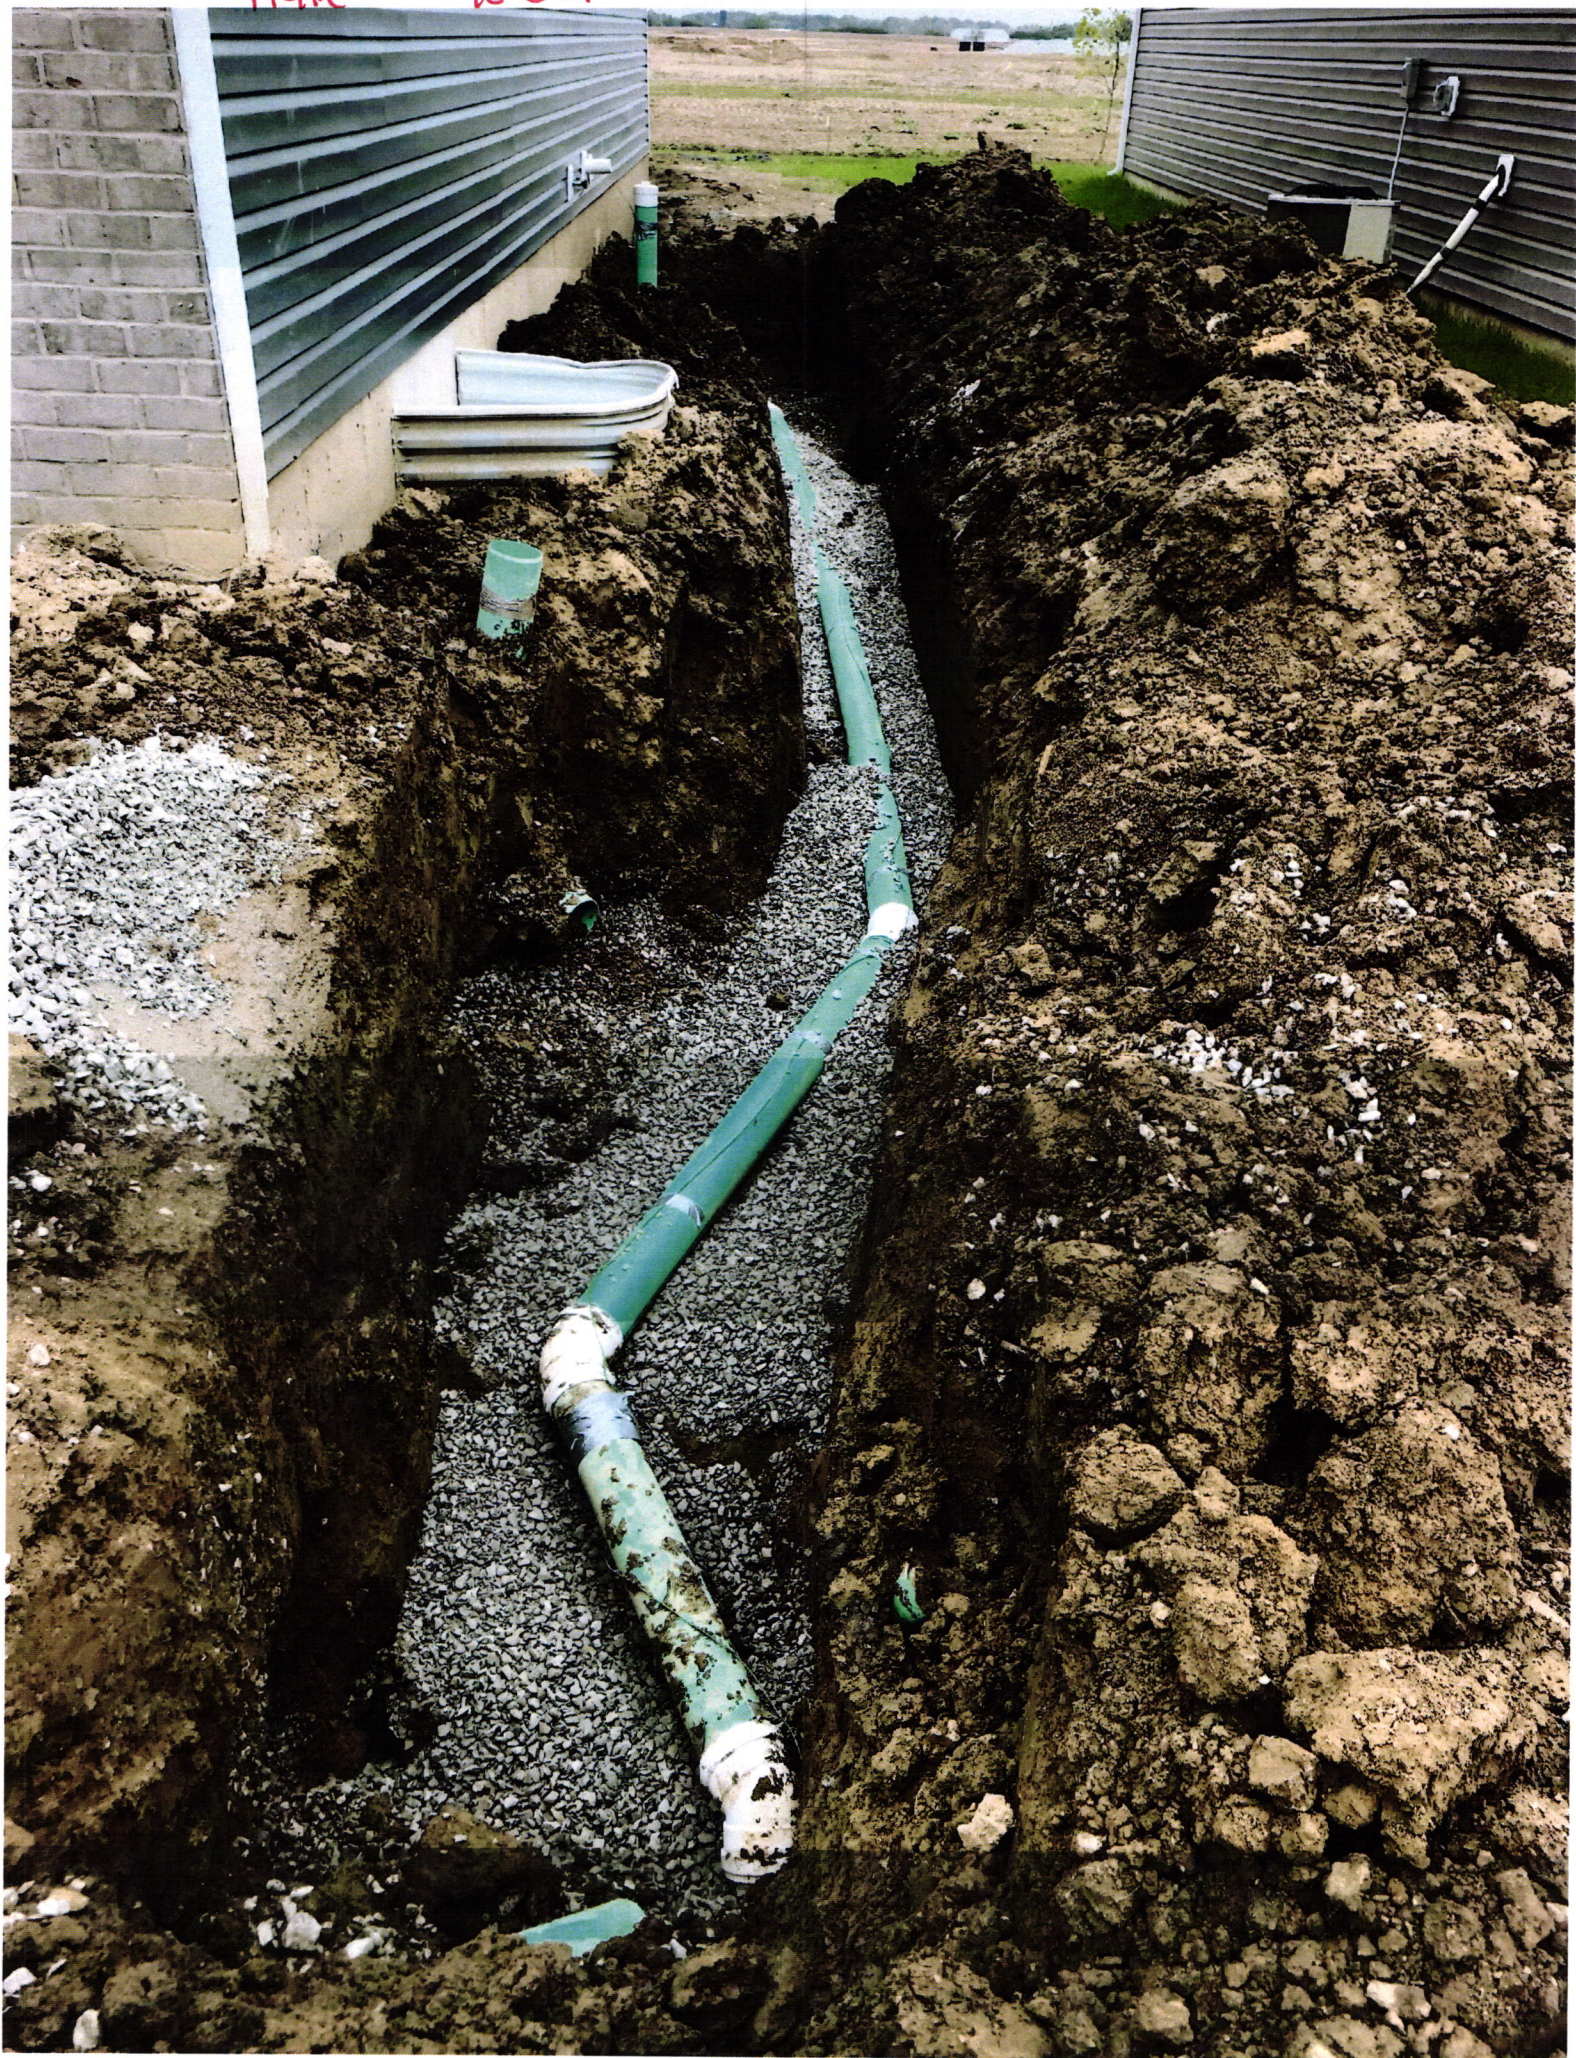



line redone 10.6.2021

↓  
do not use  
this picture!!