

1:45



FALL CREEK REGIONAL WASTE DISTRICT

Box 44, Pendleton, Indiana 46064

low sale

Bic to Jimmie Wilder

2-0009710.00

Nº 001277

APPLICATION FOR SEWER PERMIT

1-30-86

Permit No. _____ Date _____

Permit Void 90 days from Date of Issuance

400 MADISON AVE

Owner Name HOWARD SIMMERMAN PENDLETON

Property Address 6902 JACKSON ST.

Lot # _____ P.O. Box _____

Town ANDERSON, IN Zip Code 46013

Phone 778-2903 Water Meter _____

\$ 150.00 Tap on Fee Paid

\$ 25.00 Inspection fee paid

Application is hereby made for connection to the Fall Creek Regional Waste District Sewer System for the above listed property - Permit Type: Residential ☒, Commercial _____, Industrial _____, or Governmental/Institutional _____. User Information _____

All workmanship and materials shall conform to the standards of the District Ordinance as described in Ordinance 84-2 and 84-3 as amended. Acceptance and approval must be made by the District inspector or his duly authorized representative before backfilling and final connection is made to the main sewer lines. Any violation of applicable regulations will cause all lines and appurtenances in violation to be removed and replaced at the owners expense.

The Fall Creek Regional Waste District is responsible for the inspection, approval of materials, and installation techniques only. All costs for materials and installation and any liabilities resulting from same is the sole responsibility of the property owner.

I have read and fully understand the above provisions and agree to comply by said provisions.

Howard L. Simmerman

APPLICANT(S) SIGNATURE

INSPECTOR Ron

Date inspected 6-2-86 Approved ☒ Rejected _____

Reason for rejection _____

Date reinspected _____ Approved _____ Rejected _____

Notes:

Size Pipe 6 "

Type Pipe PVC

Basement Yes _____ No ☒


Sump Pump Yes _____ No ☒

Downspout to Ground Yes ☒ No _____

Septic Tank Pumped & filled Yes ☒ No _____

Contractor Eure Davis

Special Conditions _____

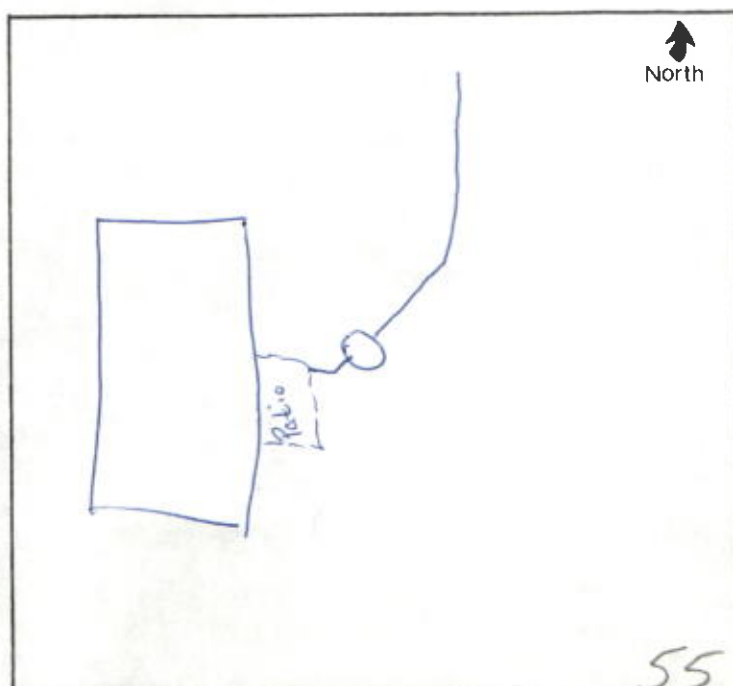

1.42



FALL CREEK REGIONAL WASTE DISTRICT

Box 22, P.O. Box 1000, Fall Creek, WI 53001

No 001277

1-30-84

TO: Mr. J. J. [illegible]
FROM: [illegible]
SUBJECT: [illegible]
[illegible text follows]

[illegible text]

Thank you for your letter of 1-25-84.

22

1-30-84



1-30-84
[illegible handwritten notes]