




Lot 372



Lot 372 maple trails 6910 Honey Suckle Lunar 6-22-22

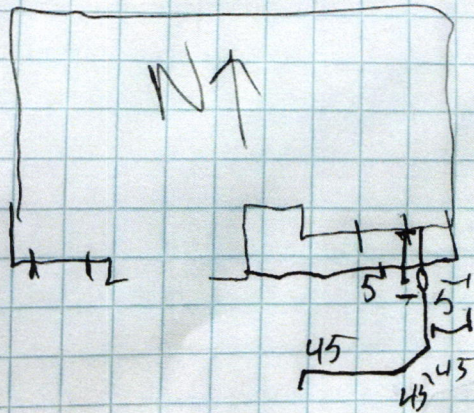

Lot 373 - 6922 Honey Suckle Lunar 6-22-22



lot 372





6910 Honeysuckle Way

Maple Trails

Sean Mitchel 6/22/2022

lot 372

