

# FALL CREEK REGIONAL WASTE DISTRICT

9378 S 650 WEST, P.O. BOX 59, PENDLETON, IN 46064  
765-778-7544

No 5340

26-08310.00

## AGREEMENT FOR SANITARY SEWER SERVICE

This Agreement made and entered into this 2 day of September, 2004, between FALL CREEK REGIONAL WASTE DISTRICT ("District") and Campbell Custom Homes ("Applicant") regarding the provision of sanitary sewer service, and the assignment of capacity in, and connection to, the District's facilities for the premises located at Lot 2, 6910 S Fountain Court

NOW THEREFORE, the parties, in consideration of the mutual promises set out in this Agreement, the receipt and sufficiency of which is hereby acknowledged, agree as follows:

1. The Applicant agrees that all workmanship and materials shall conform to all District ordinances and the District's construction standards. District must accept and approve all work and materials before backfilling and final connection is made to the sewer mains. Any violation of this provision will cause all lines and appurtenances in violation to be removed and replaced at the Applicant's expense.
2. The District shall have the right to enter upon the Applicant's premises at all reasonable times to inspect, repair, or replace any equipment used in connection with the District's service or which has an impact on said service.
3. The Applicant shall be responsible for all monthly user rates, capacity charges, and tap fees. The failure to pay any rate charge or fee may result in a lien against the property and/or the termination of service to the property, the cost of which will be borne by Applicant, including, but not limited to, all attorney's fees and collection costs.
4. The District shall not be responsible for any damages as a result of any failure to supply service unless said damages are due to default, neglect or culpability on the part of the District.
5. If there is an available sanitary sewer within three hundred (300) feet of the property line, the property owner shall be required to connect to the District's sanitary sewer system.
6. The Applicant and District agree that the provision of sanitary sewer service touches and concerns the property and the terms of this Agreement bind the District and Applicant and their heirs, executors, administrators, personal representatives, successors, agents, attorneys, assigns, designees, and transferees.

The parties hereto have read and fully understand the above provisions and agree to comply with said provisions.

FALL CREEK REGIONAL WASTE DISTRICT

Signature

APPLICANT

Signature

STATE OF INDIANA )  
 ) SS:  
COUNTY OF MADISON )

SUBSCRIBED and sworn to before me this 2nd day of September, 2004.

My Commission Expires:

4-19-2008

Signature

Printed

Notary Public

Resident of Madison County

\*\*\*\*\*  
INSPECTOR SN DATE INSPECTED 3/9/05 APPROVED \_\_\_\_\_ REJECTED \_\_\_\_\_

REASON FOR REJECTION \_\_\_\_\_

DATE REINSPECTED \_\_\_\_\_ APPROVED \_\_\_\_\_ REJECTED \_\_\_\_\_

NOTES: 1 1/2"  
SIZE PIPE 4" TYPE PIPE 160  
35

BASEMENT YES \_\_\_\_\_ NO \_\_\_\_\_

SUMP PUMP YES \_\_\_\_\_ NO \_\_\_\_\_

DOWNSPOUT TO GROUND YES \_\_\_\_\_ NO \_\_\_\_\_


SEPTIC TANK PUMPED & FILLED YES \_\_\_\_\_ NO \_\_\_\_\_

CONTRACTOR Dan Fisher

SPECIAL CONDITIONS \_\_\_\_\_

EXISTING HOME \_\_\_\_\_

NEW CONSTRUCTION ☒

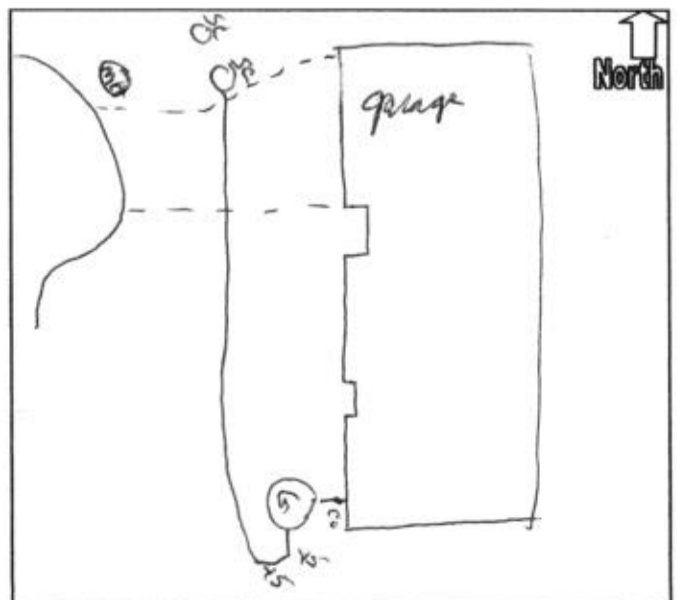



CAMPBELL CUSTOM HOMES, INC.  
6103 W. FOSTER RIDGE LANE  
PENDLETON, IN 46064

71-553/749  
7005105

5966

DATE 9/2/2004

PAY TO THE  
ORDER OF

FALL CREEK REGIONAL WASTE \$ 2635.41  
TWENTY SIX HUNDRED THIRTY FIVE DOLLARS



Madison  
Community Bank

MEMO

Lot 2 spec

Scott Campbell MP

⑆074905539⑆ 700 510 511 5966

**Signature Plumbing Co., INC.**

P.O. Box 69  
Markleville, IN 46056  
765-533-2287

**Madison Community Bank**  
State Rd 38 & Cr 300 E  
Markleville, IN 46056  
765-533-4333

**3006**

Date 3-8-05

71-553 / 7498946310

Pay to the  
Order of

FCRWD


\$ 1549.72

Fifteen hundred Forty Nine 72/100

Dollars

Memo

Lot 2 FBR

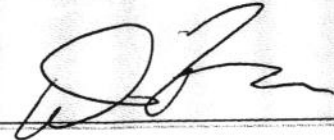

⑈074905539⑈ 894 6310 3006