

Hand-drawn sketch map of a road layout. A vertical road on the left has a 'TAP' at the top and a 'PIT' at the bottom. A horizontal road branches off to the right from the vertical road. A dashed line runs parallel to the vertical road, and another dashed line runs parallel to the horizontal road. A north arrow is in the top right corner.

MICHAEL T. STULL 04-02
MISTY M. STULL
341 BEECHWOOD AVE., APT. A
NOBLESVILLE, IN 46060

20-7043/2740
230041266

2102

DATE 5/9/04

PAY TO THE
ORDER OF

Fall Creek Regional Waste

Two thousand six hundred thirty five & 00/100

\$2635.00

DOLLARS



Security Features
Included
Details on Back



FIRST INDIANA® BANK

INDIANAPOLIS, INDIANA 46204

MEMO

Sewer Permit

MP

⑆274070439⑆ 230041266⑈ 2102

LONG & KOFFER, INC.
1795 W. HUNTSVILLE RD.
PENDLETON, INDIANA 46064
765/778-5219

NATIONAL CITY BANK OF INDIANA
INDIANAPOLIS, INDIANA 46255
20-6/740

2276

8/13/2004

PAY TO THE ORDER OF Fall Creek Regional Waste District

\$**1,549.72


One Thousand Five Hundred Forty-Nine and 72/100*****

DOLLARS

Fall Creek Regional Waste District

MEMO:

Raymond Hundley grinder

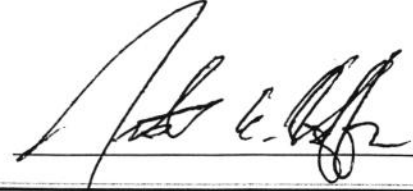

⑈002276⑈ ⑆074000065⑆ 501977276⑈