



FALL CREEK REGIONAL WASTE DISTRICT

Box 44, Pendleton, Indiana 46064

2.0011700.00

Nº 001182

APPLICATION FOR SEWER PERMIT

Permit No. _____ Date 1-13-86

Permit Void 90 days from Date of Issuance

Owner Name GARY Boyer

Property Address 6921 Fairview

Lot # _____ P.O. Box _____

Town ANDERSON, IN Zip Code 46013

Phone _____ Water Meter _____"

\$ 150.00 Tap on Fee Paid

\$ 25.00 Inspection fee paid

Application is hereby made for connection to the Fall Creek Regional Waste District Sewer System for the above listed property - Permit Type: Residential , Commercial _____, Industrial _____, or Governmental/Institutional _____. User Information _____.

All workmanship and materials shall conform to the standards of the District Ordinance as described in Ordinance 84-2 and 84-3 as amended. Acceptance and approval must be made by the District inspector or his duly authorized representative before backfilling and final connection is made to the main sewer lines. Any violation of applicable regulations will cause all lines and appurtenances in violation to be removed and replaced at the owners expense.

The Fall Creek Regional Waste District is responsible for the inspection, approval of materials, and installation techniques only. All costs for materials and installation and any liabilities resulting from same is the sole responsibility of the property owner.

I have read and fully understand the above provisions and agree to comply by said provisions.

APPLICANT(S) SIGNATURE

INSPECTOR Ben

Date inspected 1-14-86 Approved Rejected _____

Reason for rejection _____

Date reinspected _____ Approved _____ Rejected _____

Notes:

Size Pipe 6 "

Type Pipe PVC

Basement Yes _____ No


Sump Pump Yes _____ No

Downspout to Ground Yes No _____

Septic Tank Pumped & filled Yes No _____

Contractor Flat Ford + Son

Special Conditions _____

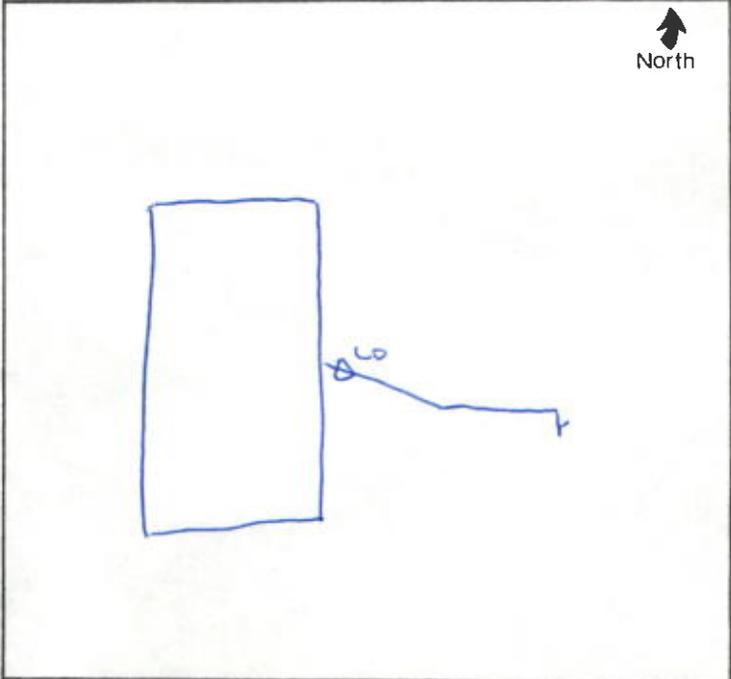

P-50