

#6467

Agreement for Sanitary Sewer Service

facilities for the premises located at FOSTERS BRANCH WOODS, LOT 1
Parcel # 48-15-13-400-053.000-014 Ridge 6924 S Fountain CT
 Now therefore, the parties, in consideration of the mutual promises set out in this Agreement, the receipt and sufficiency of which is hereby acknowledged, agree as follows:

1. The Applicant agrees that all workmanship and materials shall conform to all District ordinances and the District's construction standards. District must accept and approve all work and materials before backfilling and final connection is made to the sewer mains. Any violation of this provision will cause all lines and appurtenances in violation to be removed and replaced at the Applicant's expense.
2. The District shall have the right to enter upon the Applicant's premises at all reasonable times to inspect, repair, or replace any equipment used in connection with the District's service or which has an impact on said service.
3. The Applicant shall be responsible for all monthly user rates, capacity charges. Under const failure to pay any rate charge or fee may result in a lien against the property per Thon termination of service to the property, the cost of which will be borne by Applicant. 1-30-14 but not limited to, all attorney's fees and collection costs.
4. The District shall not be responsible for any damages as a result of any failure unless said damages are due to default, neglect or culpability on the part of the Applicant.
5. If there is an available sanitary sewer within three hundred (300) feet of the property owner shall be required to connect to the District's sanitary sewer system.
6. The Applicant and District agree that the provision of sanitary sewer service concerns the property and the terms of this Agreement bind the District and its heirs, executors, administrators, personal representatives, successors, agents, attorneys, assigns, designees, and transferees.

APPLICANT

Signature

Signature Rebecca J. McClintic



Notes:

Size Pipe 4" Type Pipe 35

Basement Yes No — 8/11/10

Sump Pump Yes No —

Downspout to Ground Yes No —


Septic Tank Pumped & Filled Yes No —

Contractor Self

Special Conditions —

Existing Home —

New Construction ✓

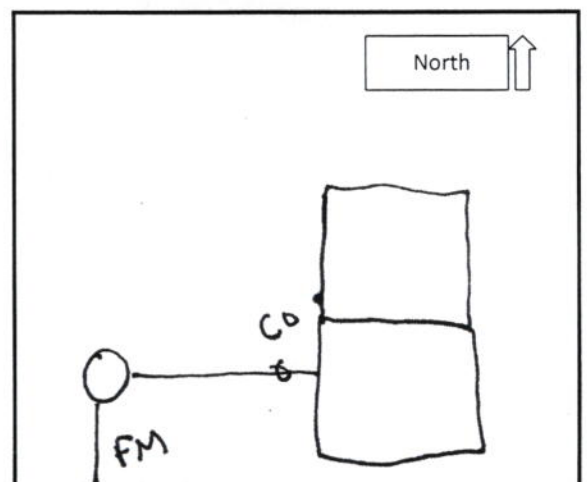

correct drawing
per Tim 4.22.14

$\frac{1}{2} \log \frac{1}{2}$

$\log \frac{1}{2} = -1$

$\log 2$



20 TWENTY DESIGN BUILD LLC
116 W ESTATE STREET
ANDERSON, IN 46013

02-13

1045

71-1/863

7/22/13

Date

Pay to the
Order of FCRWD

\$ 3,370.⁰⁰

THREE THOUSAND THREE HUNDRED SEVENTY and ⁰⁰/₁₀₀

Dollars

Security
Features
Details on
Back



OLD NATIONAL BANK

oldnational.com

For LOT 1 FOSTERS BRANCH

Ch...

MP

⑆086300012⑆ 121525724⑈ 01045

Harland Clarke

INTOUCH® CUSTOM CREATIONS®

CHAD E. LUKENS
AMY R. LUKENS
116 W. ESTATE ST.
ANDERSON, IN 46103

1010
70-7143/2812
04

9/6/13

Date

Pay to the Order of FCRWD

\$ 1660.64


ONE THOUSAND SIX HUNDRED SIXTY and ⁶⁴/₁₀₀ — Dollars

 Security Features Details on Back.



First Vincennes Savings Bank
Vincennes, IN
<http://www.frsb.net>

For FB LOT 1 GRINDER

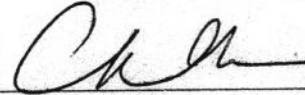

MP

⑆ 281271438⑆ 70022009⑆ 01010

Harland Clarke

INTOUCH® CUSTOM CREATIONS®