



FALL CREEK REGIONAL WASTE DISTRICT

9378 S. 650 West PO Box 59
Pendleton, IN 46064-0059 778-7544

10-24106.01

10-24106.01

No 2687

APPLICATION FOR SEWER PERMIT

Date

6/7/99

Permit Void 90 days from Date of Issuance

Owner Name

Swiftly

Property Address

6933 S SR 67

Lot #

P.O. Box

Town

Pendleton

, IN

Zip Code

46064

Phone

City Water

Well

\$

400

Tap on Fee Paid

\$

1900

capacity inspection fee paid

Application is hereby made for connection to the Fall Creek Regional Waste District Sewer System for the above listed property - Permit Type: Residential ☐, Commercial ☒, Industrial ☐, or Governmental/Institutional ☐. User Information

All workmanship and materials shall conform to the standards of the District Ordinance as described in Ordinance 84-2 and 84-3 as amended. Acceptance and approval must be made by the District inspector or his duly authorized representative before backfilling and final connection is made to the main sewer lines. Any violation of applicable regulations will cause all lines and appurtenances in violation to be removed and replaced at the owners expense.

The Fall Creek Regional Waste District is responsible for the inspection, approval of materials, and installation techniques only. All costs for materials and installation and any liabilities resulting from same is the sole responsibility of the property owner.

I have read and fully understand the above provisions and agree to comply by said provisions.

Robert L. Egin

APPLICANT(S) SIGNATURE

INSPECTOR

B

Date inspected

8-30-99

Approved

✓

Rejected

Reason for rejection

Date reinspected

Approved

Rejected

Notes:

Size Pipe

4"

Type Pipe

PVC

Basement Yes

No

✓

Sump Pump Yes

No

✓

Downspout to Ground Yes

✓

No

Septic Tank Pumped & filled Yes

No

✓

Contractor


M+M

Special Conditions

Existing Home

New Construction

✓

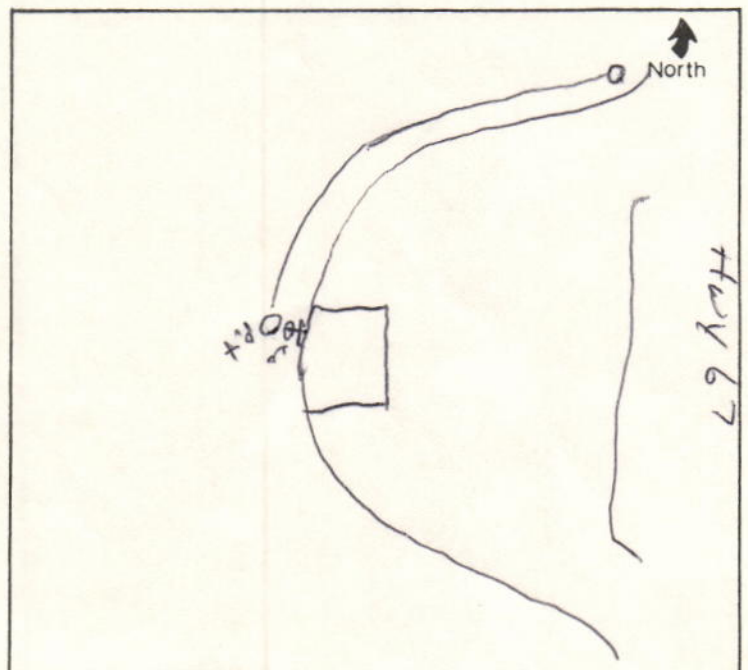

ROBERT L. ELGIN
RHONDA S. ELGIN

8760

SSN 304-68-9892 SSN 315-76-4123
2466 N EUNICE DR. PH 812-883-4087
SALEM, IN 47167

Date 6/7/99

71-7190/2695

Pay to the
order of

Fall Creek Regional Waste District

\$ 2,300.00/100

Two Thousand Three Hundred

00/100

Dollars

MID-SOUTHERN SAVINGS BANK, FSB
300 N. WATER ST. P.O. BOX 345
SALEM, INDIANA 47167

For Sum of Tap Fee

Robert L. Elgin

⑆28397190⑆

8760