

Fall Creek Regional Waste District
9378 S 650 W, P.O. Box 59, Pendleton, IN 46064
765-778-7544

#6487

Jada Sparks

Agreement for Sanitary Sewer Service

This Agreement made and entered into this 30 day of April, 2014, between Fall Creek Regional Waste District ("District") and Stephenson Residential ("Applicant") regarding the provision of sanitary sewer service, and the assignment of capacity in and connection to, the District's facilities for the premises located at Lot 22 Fosters Branch Ridge

Now therefore, the parties, in consideration of the mutual promises set out in this Agreement, the receipt and sufficiency of which is hereby acknowledged, agree as follows:

1. The Applicant agrees that all workmanship and materials shall conform to all District ordinances and the District's construction standards. District must accept and approve all work and materials before backfilling and final connection is made to the sewer mains. Any violation of this provision will cause all lines and appurtenances in violation to be removed and replaced at the Applicant's expense.
2. The District shall have the right to enter upon the Applicant's premises at all reasonable times to inspect, repair, or replace any equipment used in connection with the District's service or which has an impact on said service.
3. The Applicant shall be responsible for all monthly user rates, capacity charges, and tap fees. The failure to pay any rate charge or fee may result in a lien against the property and/or the termination of service to the property, the cost of which will be borne by Applicant, including, but not limited to, all attorney's fees and collection costs.
4. The District shall not be responsible for any damages as a result of any failure to supply service unless said damages are due to default, neglect or culpability on the part of the District.
5. If there is an available sanitary sewer within three hundred (300) feet of the property line, the property owner shall be required to connect to the District's sanitary sewer system.
6. The Applicant and District agree that the provision of sanitary sewer service touches and concerns the property and the terms of this Agreement bind the District and Applicant and their heirs, executors, administrators, personal representatives, successors, agents, attorneys, assigns, designees, and transferees.

The parties hereto have read and fully understand the above provisions and agree to comply with said provisions.

FALL CREEK REGIONAL WASTE DISTRICT
Signature Rebecca Hunter

APPLICANT 27 AK
Signature

[illegible]

SUBSCRIBED and sworn to before me this 30 day of April, 2014

My Commission Expires:
 **Commission Expires November 20, 2015**
 A Resident of
Hamilton County, Indiana
Rebecca Lynn Hunter, Notary Public

Signature Rebecca Lynn Hunter
Printed Rebecca Lynn Hunter
Notary Public
Resident of Hamilton County

Inspector Don Date Inspected 5-12-14 Approved ✓ Rejected _____
Reason for Rejection _____

Date Reinspected _____ Approved _____ Rejected _____

Notes: _____

Size Pipe 4" / 1 1/2 Type Pipe 35 / STD 9

Basement Yes No

Sump Pump Yes No

Downspout to Ground Yes No

Septic Tank Pumped & Filled Yes No


Contractor WATERWORKS

Special Conditions _____

Existing Home _____

New Construction ✓

Paid for grinder
on 7-18-14

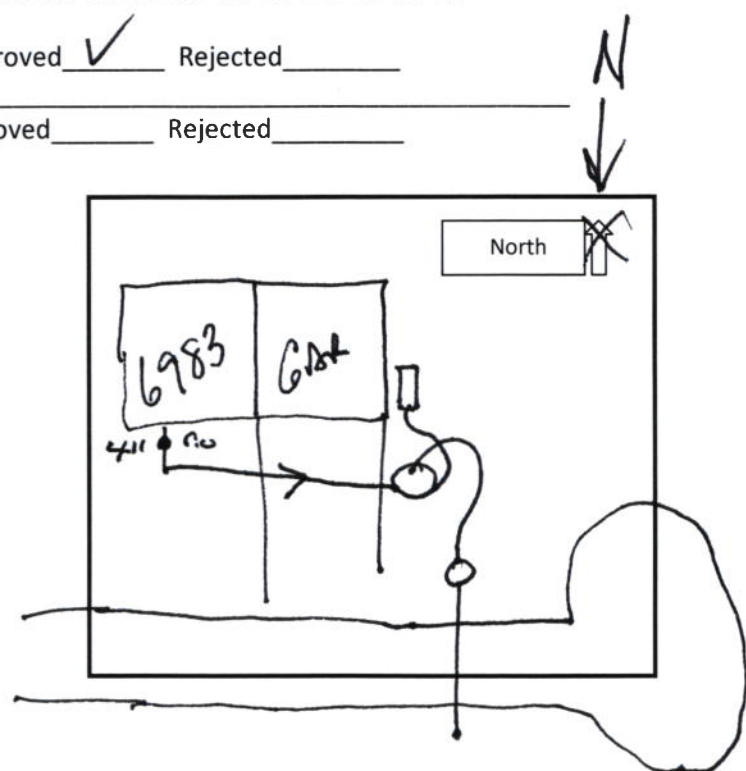

1. The first part of the
 paper is devoted to a
 discussion of the
 general principles of
 the theory of the
 subject.



2. The second part of the
 paper is devoted to a
 discussion of the
 general principles of the
 theory of the subject.

3. The third part of the
 paper is devoted to a
 discussion of the
 general principles of the
 theory of the subject.

4. The fourth part of the
 paper is devoted to a
 discussion of the
 general principles of the
 theory of the subject.

5. The fifth part of the
 paper is devoted to a
 discussion of the
 general principles of the
 theory of the subject.




STEPHENSON RESIDENTIAL LLC

71-65/749

4611

PH. 765-425-8978
925 FOREST DR.
ANDERSON, IN 46011-1235

DATE 04/30/14  Shield™

PAY TO THE
ORDER OF

FCRWD

\$ 3,370.00

THREE THOUSAND THREE HUNDRED SEVENTY DOLLARS




Security Features
Included
Details on Back



First Merchants Bank
www.firstmerchants.com

MEMO

22 FEB

[Signature] 

⑆074900657⑆9000252864⑆

4611