

Fall Creek Regional Waste District
9378 S 650 W, P.O. Box 59, Pendleton, IN 46064
765-778-7544

#6744

Agreement for Sanitary Sewer Service

This Agreement made and entered into this 18 day of April, 2018, between Fall Creek Regional Waste District ("District") and Twenty-Twenty Design ("Applicant") regarding the provision of sanitary sewer service, and the assignment of capacity in and connection to, the District's facilities for the premises located at lot #30 Foster Branch Ridge.

Street Address: 6990 S. Lakeview Ct Pendleton, IN 46064

Now therefore, the parties, in consideration of the mutual promises set out in this Agreement, the receipt and sufficiency of which is hereby acknowledged, agree as follows:

1. The Applicant agrees that all workmanship and materials shall conform to all District ordinances and the District's construction standards. District must accept and approve all work and materials before backfilling and final connection is made to the sewer mains. Any violation of this provision will cause all lines and appurtenances in violation to be removed and replaced at the Applicant's expense.
2. The District shall have the right to enter upon the Applicant's premises at all reasonable times to inspect, repair, or replace any equipment used in connection with the District's service or which has an impact on said service.
3. The Applicant shall be responsible for all monthly user rates, capacity charges, and tap fees. The failure to pay any rate charge or fee may result in a lien against the property and/or the termination of service to the property, the cost of which will be borne by Applicant, including, but not limited to, all attorney's fees and collection costs.
4. The District shall not be responsible for any damages as a result of any failure to supply service unless said damages are due to default, neglect or culpability on the part of the District.
5. If there is an available sanitary sewer within three hundred (300) feet of the property line, the property owner shall be required to connect to the District's sanitary sewer system.
6. The Applicant and District agree that the provision of sanitary sewer service touches and concerns the property and the terms of this Agreement bind the District and Applicant and their heirs, executors, administrators, personal representatives, successors, agents, attorneys, assigns, designees, and transferees.


The parties hereto have read and fully understand the above provisions and agree to comply with said provisions.

FALL CREEK REGIONAL WASTE DISTRICT
Rachel E. Anderson
Signature

APPLICANT
[Signature]
Signature

STATE OF INDIANA)
) SS:
COUNTY OF MADISON)

SUBSCRIBED and sworn to before me this 18 day of April, 2018

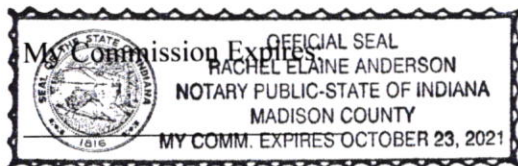


Signature Rachel E. Anderson
Printed Rachel E. Anderson
Notary Public
Resident of Madison county

Inspector SN Date Inspected 4/19/18 Approved ✓ Rejected _____
Reason for Rejection _____

Date Reinspected _____ Approved _____ Rejected _____

Notes:

Size Pipe 4" 1/2 Type Pipe 35 / 160
Basement Yes No
Sump Pump Yes No
Downspout to Ground Yes No
Septic Tank Pumped & Filled Yes No
Contractor Koffler
Special Conditions _____
Existing Home _____
New Construction ✓

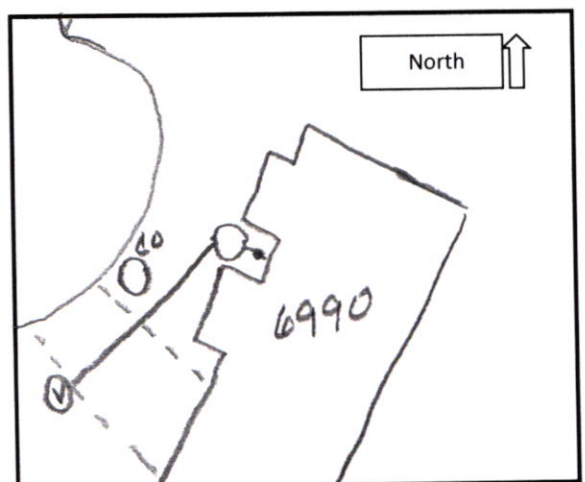

1 picture attached

6990 S Lakeview CT
FBR Lot 30

Steve Nicholson
4.19.18



20 TWENTY DESIGN BUILD LLC

02-13

3221

PO BOX 237

71-1/863

PENDLETON, IN 46064

4-16-18

Date

CHECK AMOUNT

Pay to the Order of FCRWD

\$ 5,926.23

FIVE THOUSAND NINE HUNDRED TWENTY SIX and ²³/₁₀₀ — Dollars

Photo Safe Deposit® Details on back

OLD NATIONAL BANK

oldnational.com

For GALE

Ch

MP

Rec. # 010750