

9378 S 650 WEST, P.O. BOX 59, PENDLETON, IN 46064

765-778-7544

AGREEMENT FOR SANITARY SEWER SERVICE

This Agreement made and entered into this 22 day of June, 2004, between FALL CREEK REGIONAL WASTE DISTRICT ("District") and Quin & Shelly Ricker ("Applicant") regarding the provision of sanitary sewer service, and the assignment of capacity in, and connection to, the District's facilities for the premises located at Lot 20 Foster Branch Ridge.

NOW THEREFORE, the parties, in consideration of the mutual promises set out in this Agreement, the receipt and sufficiency of which is hereby acknowledged, agree as follows:

1. The Applicant agrees that all workmanship and materials shall conform to all District ordinances and the District's construction standards. District must accept and approve all work and materials before backfilling and final connection is made to the sewer mains. Any violation of this provision will cause all lines and appurtenances in violation to be removed and replaced at the Applicant's expense.
2. The District shall have the right to enter upon the Applicant's premises at all reasonable times to inspect, repair, or replace any equipment used in connection with the District's service or which has an impact on said service.
3. The Applicant shall be responsible for all monthly user rates, capacity charges, and tap fees. The failure to pay any rate charge or fee may result in a lien against the property and/or the termination of service to the property, the cost of which will be borne by Applicant, including, but not limited to, all attorney's fees and collection costs.
4. The District shall not be responsible for any damages as a result of any failure to supply service unless said damages are due to default, neglect or culpability on the part of the District.
5. If there is an available sanitary sewer within three hundred (300) feet of the property line, the property owner shall be required to connect to the District's sanitary sewer system.
6. The Applicant and District agree that the provision of sanitary sewer service touches and concerns the property and the terms of this Agreement bind the District and Applicant and their heirs, executors, administrators, personal representatives, successors, agents, attorneys, assigns, designees, and transferees.

The parties hereto have read and fully understand the above provisions and agree to comply with said provisions.

FALL CREEK REGIONAL WASTE DISTRICT

Seresa R. Hutton
Signature

~~APPLICANT~~

Signature _____

[illegible]

SUBSCRIBED and sworn to before me this 22 day of June, 2004

My Commission Expires: _____

4-19-2008

Signature

Printed

Notary Public

Resident of Madison County

INSPECTOR _____ DATE INSPECTED 11/04 APPROVED _____ REJECTED _____

REASON FOR REJECTION

DATE REINSPECTED _____ APPROVED _____ REJECTED _____

NOTES:

SIZE PIPE _____ TYPE PIPE _____

BASEMENT YES NO

SUMP PUMP YES NO

DOWNSPOUT TO GROUND YES NO


SEPTIC TANK PUMPED & FILLED YES NO

CONTRACTOR

SPECIAL CONDITIONS

EXISTING HOME

NEW CONSTRUCTION

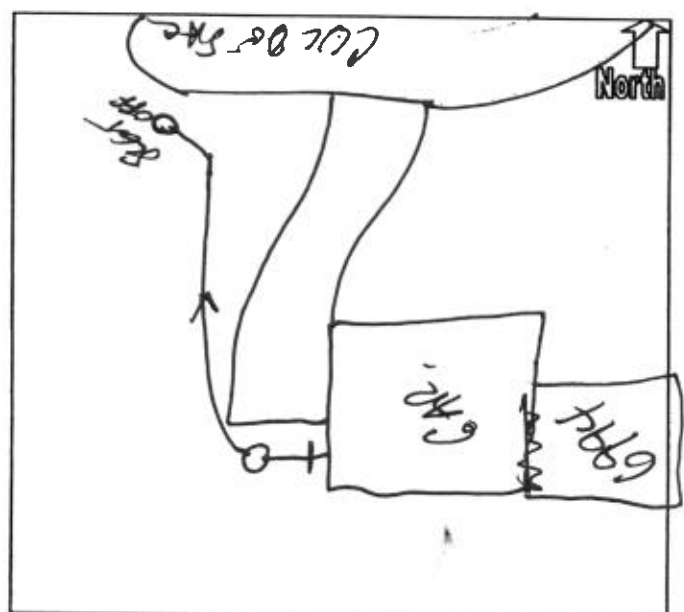

CAMPBELL CUSTOM HOMES, INC.
6103 W. FOSTER RIDGE LANE
PENDLETON, IN 46064

71-553/749
7005105

5848

DATE

6/22/2004

PAY TO THE
ORDER OF

FALL CREEK FEDERAL NATL WAST \$2635.⁰⁰
TWENTY SIX HUNDRED THIRTY FIVE
DOLLARS



Madison
Community Bank

MEMO

LOT 20 TRACT

[Signature]

⑆074905539⑆ 700 510 51 5848

Signature Plumbing Co., INC.

P.O. Box 69
Markleville, IN 46056
765-533-2287

Madison Community Bank
State Rd 38 & Cr 300 E
Markleville, IN 46056
765-533-4333

2869

Date 11/5/2004

71-553 / 7498946310

Pay to the

Order of Fall Creek Regional waste District

\$ **1,549.72

One Thousand Five Hundred Forty-Nine and 72/100***** Dollars

Fall Creek Regional waste District
P.O. Box 59
Pendleton, IN 46064

Memo

Desira Fesler

⑆074905539⑆ 894 6310 2869