



FALL CREEK REGIONAL WASTE DISTRICT

9378 S. 650 West PO Box 59
Pendleton, IN 46064-0059 778-7544

add order
on file

APPLICATION FOR SEWER PERMIT

Nº 2753

Date 4-13-00

Permit Void 90 days from Date of Issuance

Owner Name Ralph E. GinderProperty Address 6995 S 600W

Lot # _____ P.O. Box _____

Town Pendleton Ind, IN Zip Code 46064Phone 765-778-3265 City Water _____ Well ☒\$ 2556.00 Tap on Fee Paid pd. 5/4/00 pd. grinder unit 1024.80

\$ _____ Inspection fee paid _____

Steve Patterson - contractor

Application is hereby made for connection to the Fall Creek Regional Waste District Sewer System for the above listed property - Permit Type: Residential ☒, Commercial _____, Industrial _____, or Governmental/Institutional _____. User Information _____.

All workmanship and materials shall conform to the standards of the District Ordinance as described in Ordinance 84-2 and 84-3 as amended. Acceptance and approval must be made by the District inspector or his duly authorized representative before backfilling and final connection is made to the main sewer lines. Any violation of applicable regulations will cause all lines and appurtenances in violation to be removed and replaced at the owners expense.

The Fall Creek Regional Waste District is responsible for the inspection, approval of materials, and installation techniques only. All costs for materials and installation and any liabilities resulting from same is the sole responsibility of the property owner.

I have read and fully understand the above provisions and agree to comply by said provisions.

Ralph E. Ginder
APPLICANT(S) SIGNATURE

INSPECTOR DJDate inspected 5-9-00 Approved ☒ Rejected _____

Reason for rejection _____

Date reinspected _____ Approved _____ Rejected _____


Notes:
Size Pipe 4" LAT / 1 1/2 ft
Type Pipe WC35 / 160 PSI.

Basement Yes _____ No ☒Sump Pump Yes _____ No ☒Downspout to Ground Yes ☒ No _____Septic Tank Pumped & filled Yes ☒ No _____Contractor PATTERSON EXC.

Special Conditions _____

Existing Home ☒

New Construction _____

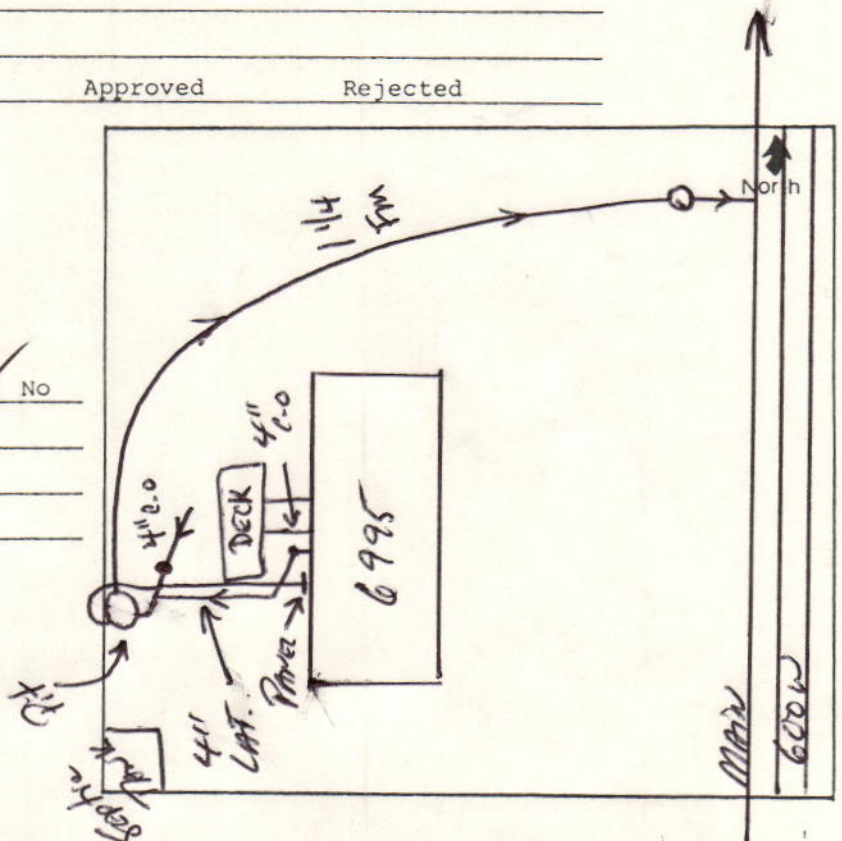


MR. & MRS. RALPH E. GINDER 1-68
6995 S. 600 W
PENDLETON, IN 46064

1577

DATE 5-4-00

71-553/749
BRANCH 0

PAY TO THE ORDER OF Fall Creek Regional Water Dist \$ 2200 ⁴⁵/₁₀₀
Two Thousand twenty two ⁴⁵/₁₀₀ DOLLARS  Security features included. Details on back.



Madison
Community Bank



FOR In full Ralph E. Ginder
⑆074905539⑆ 255 000 011 1577

© HARLAND 1995