

FALL CREEK REGIONAL WASTE DISTRICT

9378 S 650 WEST, P.O. BOX 59, PENDLETON, IN 46064
765-778-7544

AGREEMENT FOR SANITARY SEWER SERVICE

4567

Ahdoot

26-68580.00

This Agreement made and entered into this 19th day of March, 2002, between FALL CREEK REGIONAL WASTE DISTRICT ("District") and Barrington Custom Homes ("Applicant") regarding the provision of sanitary sewer service, and the assignment of capacity in, and connection to, the District's facilities for the premises located at 10129, 6995 Lakeview Ct, 6995 S Lakeview
Fosters Branch Ridge

NOW THEREFORE, the parties, in consideration of the mutual promises set out in this Agreement, the receipt and sufficiency of which is hereby acknowledged, agree as follows:

1. The Applicant agrees that all workmanship and materials shall conform to all District ordinances and the District's construction standards. District must accept and approve all work and materials before backfilling and final connection is made to the sewer mains. Any violation of this provision will cause all lines and appurtenances in violation to be removed and replaced at the Applicant's expense.
2. The District shall have the right to enter upon the Applicant's premises at all reasonable times to inspect, repair, or replace any equipment used in connection with the District's service or which has an impact on said service.
3. The Applicant shall be responsible for all monthly user rates, capacity charges, and tap fees. The failure to pay any rate charge or fee may result in a lien against the property and/or the termination of service to the property, the cost of which will be borne by Applicant, including, but not limited to, all attorney's fees and collection costs.
4. The District shall not be responsible for any damages as a result of any failure to supply service unless said damages are due to default, neglect or culpability on the part of the District.
5. If there is an available sanitary sewer within three hundred (300) feet of the property line, the property owner shall be required to connect to the District's sanitary sewer system.
6. The Applicant and District agree that the provision of sanitary sewer service touches and concerns the property and the terms of this Agreement bind the District and Applicant and their heirs, executors, administrators, personal representatives, successors, agents, attorneys, assigns, designees, and transferees.

The parties hereto have read and fully understand the above provisions and agree to comply with said provisions.

FALL CREEK REGIONAL WASTE DISTRICT

Signature Deborah Wilson

APPLICANT

Signature Mark Bo

STATE OF INDIANA)

) SS:

COUNTY OF MADISON)

SUBSCRIBED and sworn to before me this 19th day of March, 2002.

My Commission Expires:

2-20-2008

Signature Deborah L. Wilson

Printed Deborah L. Wilson

Notary Public

Resident of Madison County

INSPECTOR B DATE INSPECTED 3-2-02 APPROVED ✓ REJECTED _____

REASON FOR REJECTION _____

DATE REINSPECTED _____ APPROVED _____ REJECTED _____

NOTES:

SIZE PIPE 4" 1.5' TYPE PIPE PVC

BASEMENT YES NO ✓

SUMP PUMP YES NO ✓

DOWNSPOUT TO GROUND YES NO new


SEPTIC TANK PUMPED & FILLED YES NO ✓

CONTRACTOR Long & K. Fork

SPECIAL CONDITIONS _____

EXISTING HOME _____

NEW CONSTRUCTION ✓

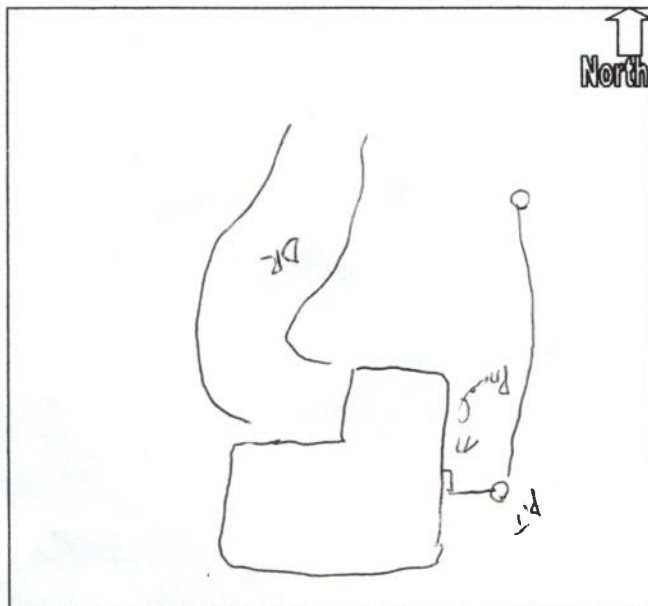

1045

BARRINGTON CUSTOM HOMES, LLC

5448 WOODFIELD DR.
CARMEL, IN 46033DATE 3/13/10

20-1403/740

PAY

TO THE

ORDER OF

Fall Creek Regional West\$ 2635⁰⁰Two Thousand Six Hundred Thirty FiveDOLLARS  Security features
included.
Details on back. **Salin Bank**
AND TRUST COMPANY
SERVING PEOPLE THROUGHOUT INDIANA

FOR



MP

⑈001045⑈ ⑆074014035⑆ 10018053⑈

Mark Zuckerman

01023748496001
LTM104-1
McBEE 1 800 862-2331 00007268400

LONG & KOFFER, INC.
1795 W. HUNTSVILLE RD.
PENDLETON, INDIANA 46064
765/778-5219

NATIONAL CITY BANK OF INDIANA
INDIANAPOLIS, INDIANA 46255
20-6/740

1588

3/19/2002

PAY TO THE
ORDER OF

Fall Creek Regional Waste District


\$ **1,024.80

One Thousand Twenty-Four and 80/100*****

DOLLARS

Fall Creek Regional Waste District

MEMO:

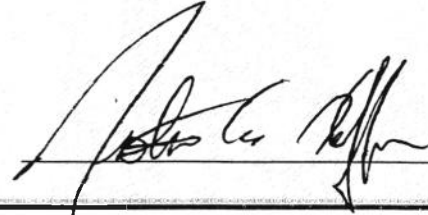

⑈001588⑈ ⑆074000065⑆ 501977276⑈

SECURITY FEATURES: MICRO PRINT TOP & BOTTOM BORDERS - COLORED PATTERN - ARTIFICIAL WATERMARK ON REVERSE SIDE - MISSING FEATURE INDICATES A COPY