

Side


PROJECT Phase II SHEET _____ OF _____

SUBJECT _____ DATE 5-9-18

JOB NO. 4447

BY Atlas

701 S. Broadway

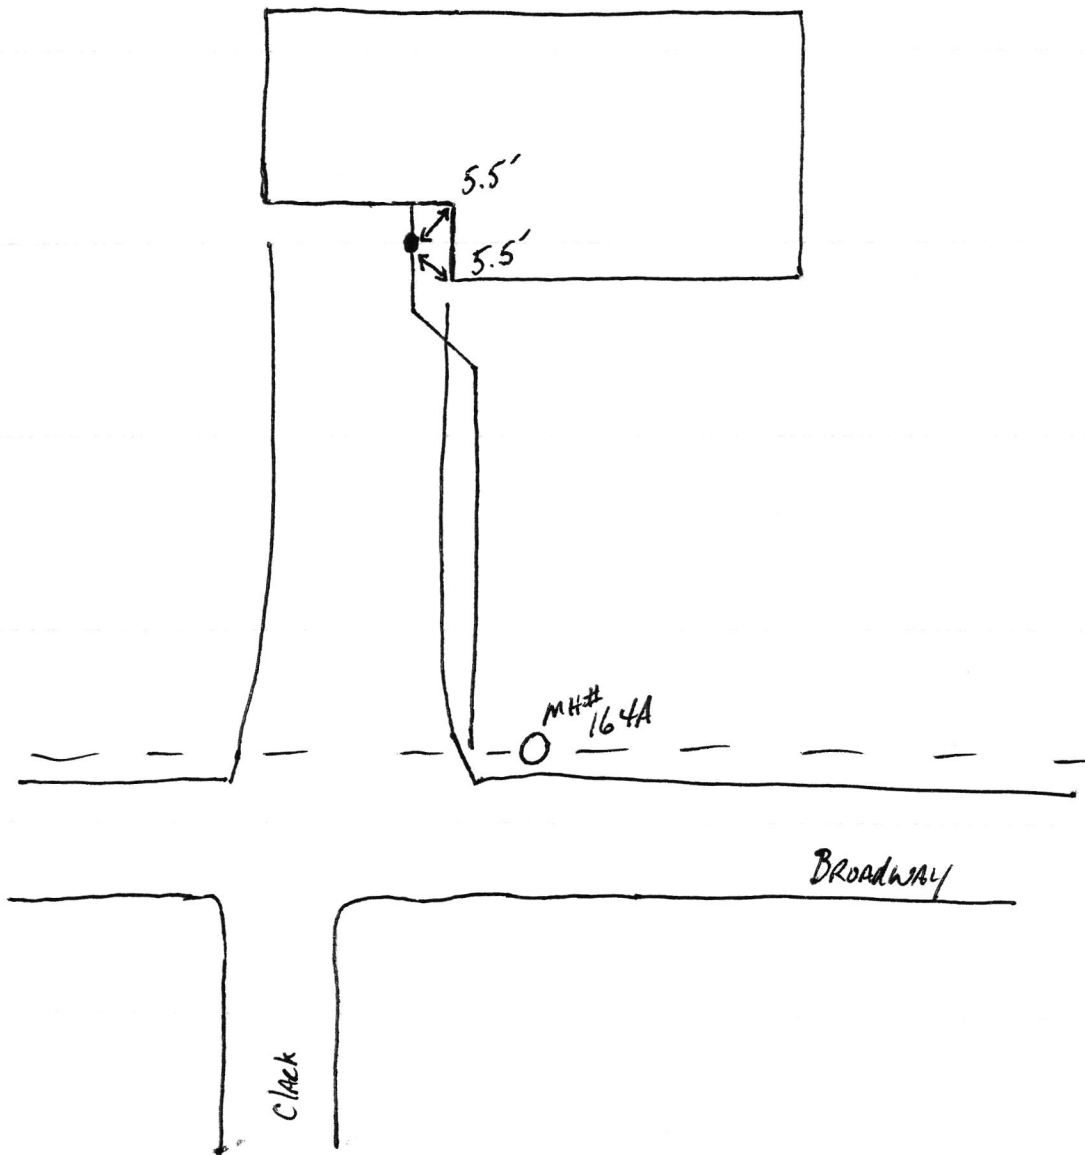

101 > Broadway

SPF Phase II

5.14.18

