

*Side*


PROJECT Phase II SHEET \_\_\_\_\_ OF \_\_\_\_\_

SUBJECT \_\_\_\_\_ DATE 5-9-18

JOB NO. 4447

BY Atlas

701 S. Broadway

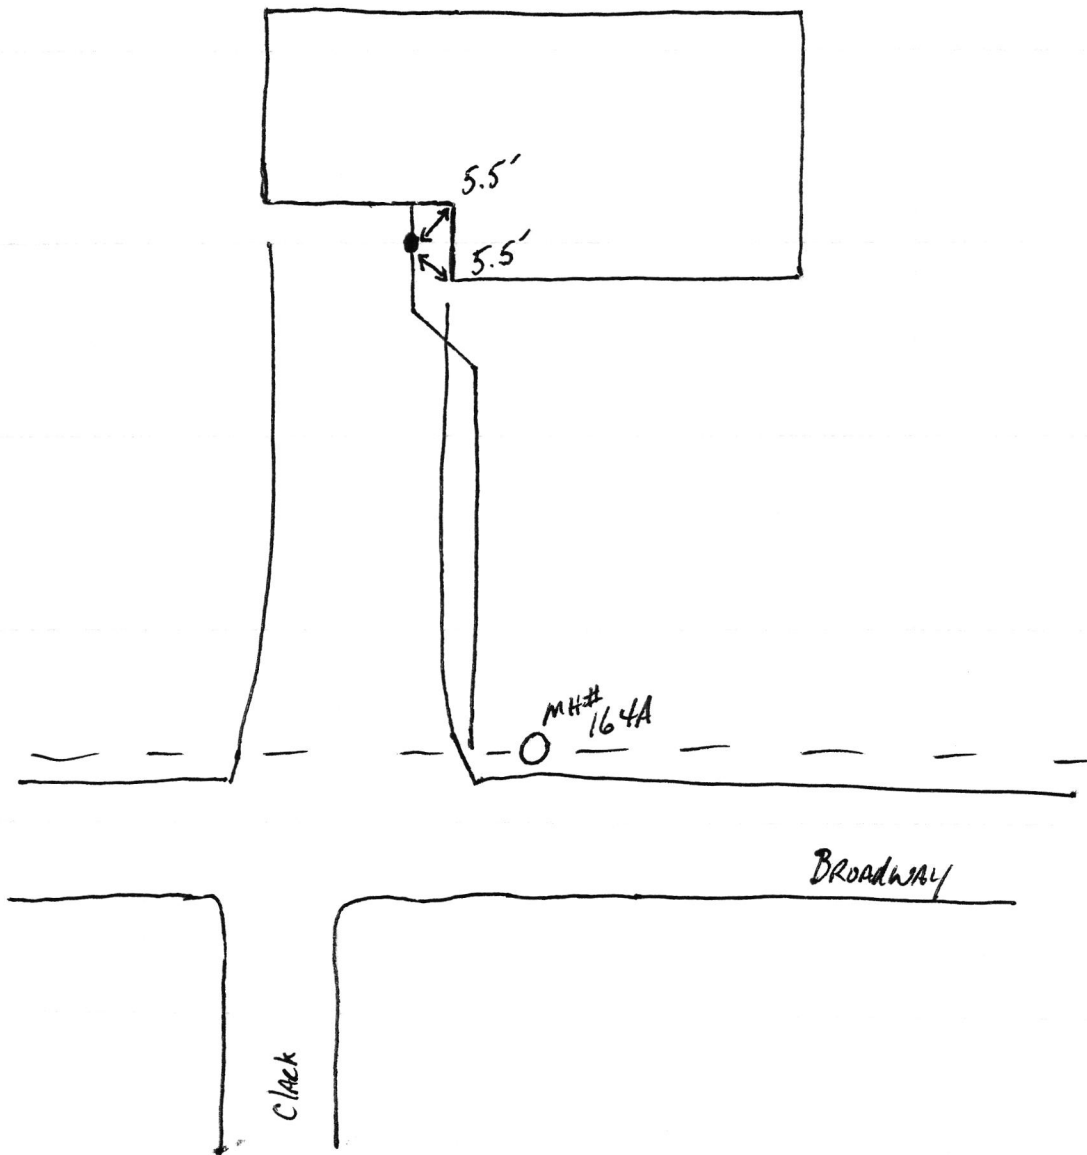



101 > Broadway

SPF Phase II

5.14.18









