


Gidw.


PROJECT Phase II SHEET _____ OF _____
SUBJECT _____ DATE 6-19-18
JOB NO 4447
BY Atlas

701 S. Pendleton

← N

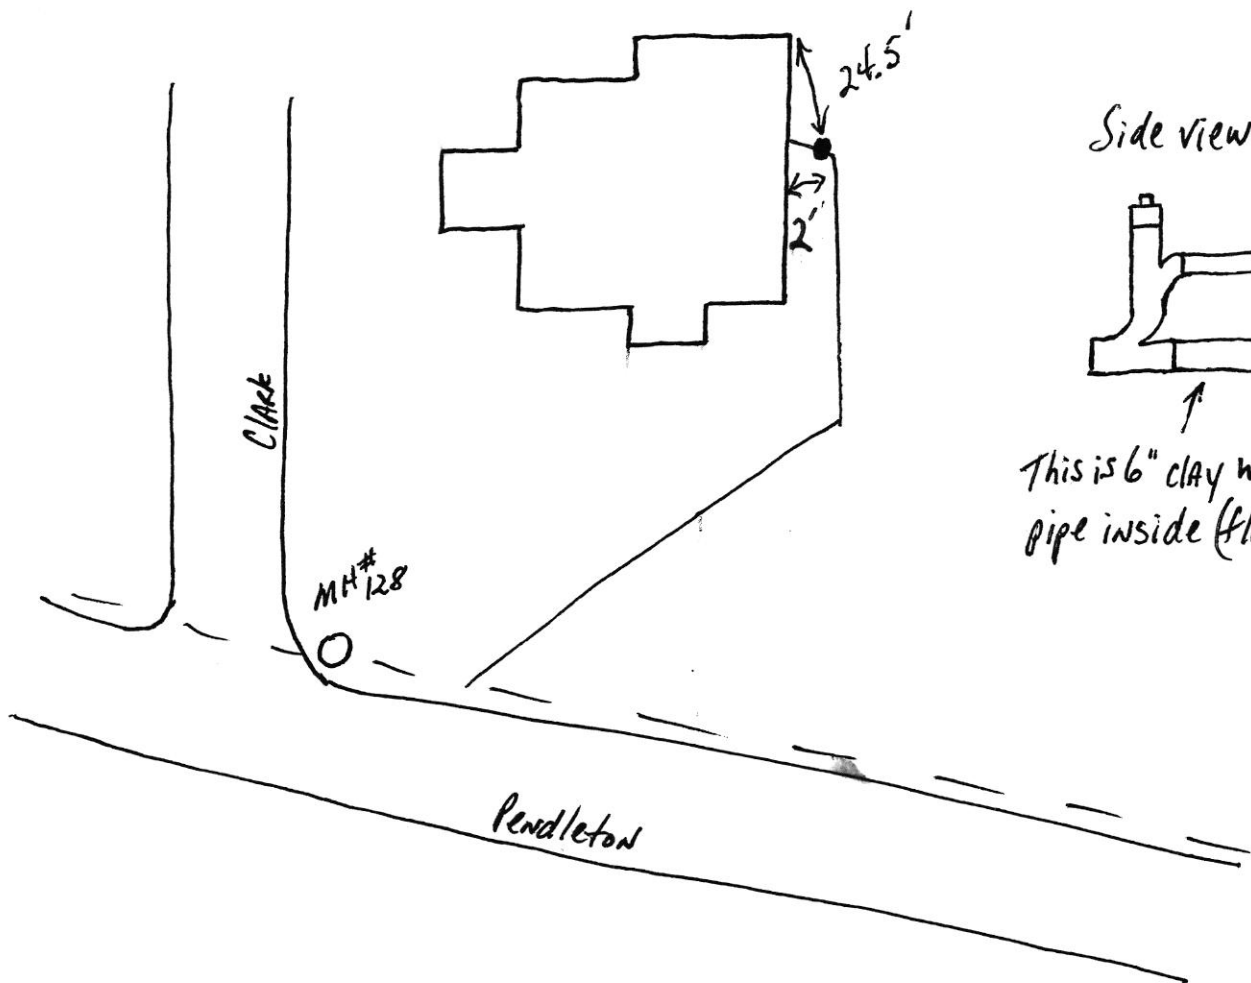

Side view

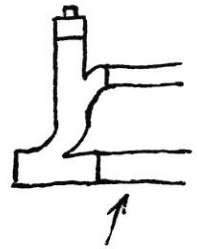

↑
This is 6" clay w/a 2"
pipe inside (floor drains)

101 S Pendleton

SRE Phase II

6-25-18

