

22-24155.00

FALL CREEK REGIONAL WASTE DISTRICT

No 6349

9378 S 650 WEST, P.O. BOX 59, PENDLETON, IN 46064

765-778-7544

AGREEMENT FOR SANITARY SEWER SERVICE

Brad & Jill
McKinney

This Agreement made and entered into this 16 day of October, 2008, between FALL CREEK REGIONAL WASTE DISTRICT ("District") and Brad Holloway Homes ("Applicant") regarding the provision of sanitary sewer service, and the assignment of capacity in, and connection to, the District's facilities for the premises located at Trillium Woods lot 32

7055 Mayapple Lane

NOW THEREFORE, the parties, in consideration of the mutual promises set out in this Agreement, the receipt and sufficiency of which is hereby acknowledged, agree as follows:

1. The Applicant agrees that all workmanship and materials shall conform to all District ordinances and the District's construction standards. District must accept and approve all work and materials before backfilling and final connection is made to the sewer mains. Any violation of this provision will cause all lines and appurtenances in violation to be removed and replaced at the Applicant's expense.
2. The District shall have the right to enter upon the Applicant's premises at all reasonable times to inspect, repair, or replace any equipment used in connection with the District's service or which has an impact on said service.
3. The Applicant shall be responsible for all monthly user rates, capacity charges, and tap fees. The failure to pay any rate charge or fee may result in a lien against the property and/or the termination of service to the property, the cost of which will be borne by Applicant, including, but not limited to, all attorney's fees and collection costs.
4. The District shall not be responsible for any damages as a result of any failure to supply service unless said damages are due to default, neglect or culpability on the part of the District.
5. If there is an available sanitary sewer within three hundred (300) feet of the property line, the property owner shall be required to connect to the District's sanitary sewer system.
6. The Applicant and District agree that the provision of sanitary sewer service touches and concerns the property and the terms of this Agreement bind the District and Applicant and their heirs, executors, administrators, personal representatives, successors, agents, attorneys, assigns, designees, and transferees.

The parties hereto have read and fully understand the above provisions and agree to comply with said provisions.

FALL CREEK REGIONAL WASTE DISTRICT
Rebecca Hunter
Signature

APPLICANT

Signature

STATE OF INDIANA)
) SS:
COUNTY OF MADISON)

SUBSCRIBED and sworn to before me this 16 day of October, 2008.

My Commission Expires:

Commission Expires November 20, 2015

A Resident of

Hamilton County, Indiana

Rebecca Lynn Hunter, Notary Public



Signature

Printed

Notary Public

Resident of Madison CountyHamilton County

INSPECTOR Don DATE INSPECTED 12/12/08 APPROVED ☒ REJECTED ☐

REASON FOR REJECTION _____

DATE REINSPECTED _____ APPROVED _____ REJECTED _____

NOTES:
SIZE PIPE 6" TYPE PIPE PVC

BASEMENT YES ☒ NO ☐

SUMP PUMP YES ☒ NO ☐

DOWNSPOUT TO GROUND YES ☒ NO ☐


SEPTIC TANK PUMPED & FILLED YES ☒ NO ☐

CONTRACTOR BL Brown

SPECIAL CONDITIONS _____

EXISTING HOME _____

NEW CONSTRUCTION ☒

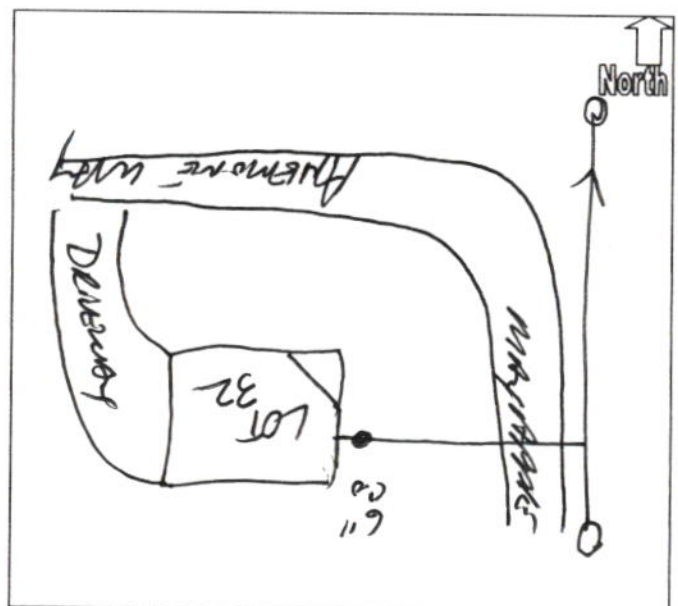

2805

ROD HOLLOWAY HOMES, INC.

765-778-8291
325 E. 1000 S.
PENDLETON, IN 46064

NATIONAL CITY BANK
20-6/740

10-16-08

PAY TO THE
ORDER OF

Fall Creek Regional Waste District

\$ 3370.00

Three thousand three hundred seventy and ⁰⁰/₁₀₀ DOLLARS

MEMO

Lot 32 Tullum Woods

Rodney C. Holloway
AUTHORIZED SIGNATURE

⑈002805⑈ ⑈074000065⑈