

FALL CREEK REGIONAL WASTE DISTRICT

9378 S 650 WEST, P.O. BOX 59, PENDLETON, IN 46064

765-778-7544

AGREEMENT FOR SANITARY SEWER SERVICE

This Agreement made and entered into this 18th day of February, 2004, between FALL CREEK REGIONAL WASTE DISTRICT ("District") and Curtis Sigler ("Applicant") regarding the provision of sanitary ~~sewer service~~, and the assignment of capacity in, and connection to, the District's facilities for the premises located at 7054 W Fall Creek Drive, Bendleton.

NOW THEREFORE, the parties, in consideration of the mutual promises set out in this Agreement, the receipt and sufficiency of which is hereby acknowledged, agree as follows:

1. The Applicant agrees that all workmanship and materials shall conform to all District ordinances and the District's construction standards. District must accept and approve all work and materials before backfilling and final connection is made to the sewer mains. Any violation of this provision will cause all lines and appurtenances in violation to be removed and replaced at the Applicant's expense.
2. The District shall have the right to enter upon the Applicant's premises at all reasonable times to inspect, repair, or replace any equipment used in connection with the District's service or which has an impact on said service.
3. The Applicant shall be responsible for all monthly user rates, capacity charges, and tap fees. The failure to pay any rate charge or fee may result in a lien against the property and/or the termination of service to the property, the cost of which will be borne by Applicant, including, but not limited to, all attorney's fees and collection costs.
4. The District shall not be responsible for any damages as a result of any failure to supply service unless said damages are due to default, neglect or culpability on the part of the District.
5. If there is an available sanitary sewer within three hundred (300) feet of the property line, the property owner shall be required to connect to the District's sanitary sewer system.
6. The Applicant and District agree that the provision of sanitary sewer service touches and concerns the property and the terms of this Agreement bind the District and Applicant and their heirs, executors, administrators, personal representatives, successors, agents, attorneys, assigns, designees, and transferees.

The parties hereto have read and fully understand the above provisions and agree to comply with said provisions.

FALL CREEK REGIONAL WASTE DISTRICT
Signature

APPLICANT
Signature

STATE OF INDIANA)
) SS:
COUNTY OF MADISON)

SUBSCRIBED and sworn to before me this 18 day of February, 2004

My Commission Expires: 2-20-2008

Signature Deborah L. Wilson
Printed Deborah L. Wilson
Notary Public
Resident of Madison County

INSPECTOR TK DATE INSPECTED 7/14/04 APPROVED ✓ REJECTED

REASON FOR REJECTION

DATE REINSPECTED APPROVED REJECTED

NOTES: SIZE PIPE $1\frac{1}{2}$ " TYPE PIPE 160 PSI

BASEMENT YES NO

SUMP PUMP YES NO

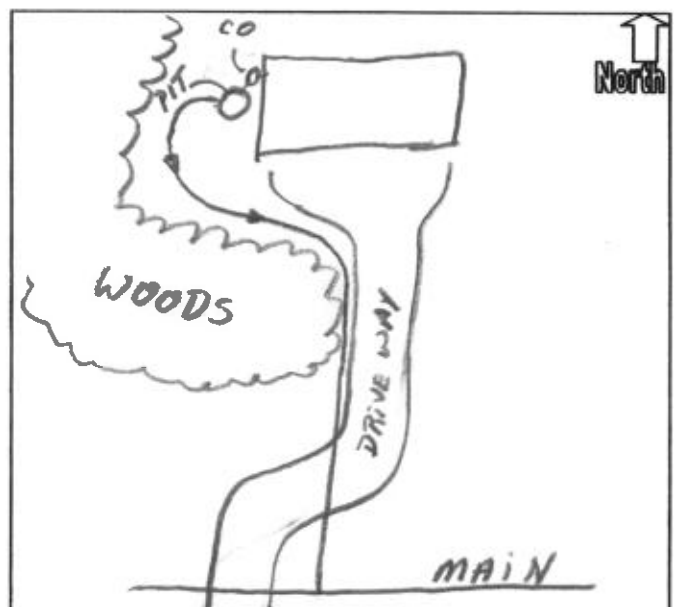
DOWNSPOUT TO GROUND YES NO

SEPTIC TANK PUMPED & FILLED YES NO 1

CONTRACTOR GERRY FREDRICKS

SPECIAL CONDITIONS —

EXISTING HOME

NEW CONSTRUCTION ☒

Published for the American Medical Association, 535 North Dearborn Street, Chicago, Ill. Entered as Second-Class Matter, October 3, 1917, under Post Office No. 384, at Chicago, Ill., under special agreement of Post Office and General Administration. Accepted for mailing at special rate of postage provided for in Act of October 3, 1917. Postage paid at Chicago, Ill.

Subscription price, Five Dollars per Annum in Advance. Single Copies, Fifteen Cents. Entered as Second-Class Matter, October 3, 1917, under Post Office No. 384, at Chicago, Ill., under special agreement of Post Office and General Administration. Accepted for mailing at special rate of postage provided for in Act of October 3, 1917. Postage paid at Chicago, Ill.

Copyright, 1919, by American Medical Association. All rights reserved. Printed at the Chicago Press, Chicago, Ill.

Published for the American Medical Association, 535 North Dearborn Street, Chicago, Ill.

Subscription price, Five Dollars per Annum in Advance. Single Copies, Fifteen Cents.

Entered as Second-Class Matter, October 3, 1917, under Post Office No. 384, at Chicago, Ill., under special agreement of Post Office and General Administration. Accepted for mailing at special rate of postage provided for in Act of October 3, 1917. Postage paid at Chicago, Ill.

Copyright, 1919, by American Medical Association. All rights reserved. Printed at the Chicago Press, Chicago, Ill.

Published for the American Medical Association, 535 North Dearborn Street, Chicago, Ill.

Subscription price, Five Dollars per Annum in Advance. Single Copies, Fifteen Cents.

Entered as Second-Class Matter, October 3, 1917, under Post Office No. 384, at Chicago, Ill., under special agreement of Post Office and General Administration. Accepted for mailing at special rate of postage provided for in Act of October 3, 1917. Postage paid at Chicago, Ill.

Copyright, 1919, by American Medical Association. All rights reserved. Printed at the Chicago Press, Chicago, Ill.

Published for the American Medical Association, 535 North Dearborn Street, Chicago, Ill.

Subscription price, Five Dollars per Annum in Advance. Single Copies, Fifteen Cents.

AMY M. OR CURTIS L. SIGLER 9-99
765 N PENDLETON AVE. 765-778-8446
PENDLETON, IN 46064

20-7043-2740

1816

Date March 2, 2004

Pay To
The Order Of

FCRWD

\$ 4,289.57

Four Thousand Two Hundred and eighty-nine

57
100

Dollars



Security Features
Included
Details on Back

FIRST INDIANA BANK
INDIANAPOLIS, INDIANA 46204

For

[Signature]

MP

⑆ 274070439⑆ 170012313⑆ 1816

4184.72
104.85

top, capacity & grinder
payment on account for
765 N Pendleton Avenue

REFERENCE / INVOICE NO.

APV NUMBER

INVOICE AMOUNT

BALANCE

30/04 refund of connection fees per grant \$4,184.72

Tap fee \$475.00

Capacity Fee \$2160.00

Grinder Unit \$1462.00

Sales Tax \$87.72

HOLD AND RETAIN FOR YOUR RECORDS

NOT VOID TWO (2)
PER DEC. 31 OF
YEAR OF ISSUE

FORM APPROVED BY STATE BOARD OF ACCOUNTS FOR FALL CREEK REGIONAL WASTE DISTRICT - 1988

FALL CREEK REGIONAL WASTE DISTRICT

PENDLETON, INDIANA 46064

71-553/749

019520

ORDER OF:

DATE

CHECK NUMBER

FUND

PAY EXACTLY

9/30/04

19520

100

\$4,184.72

*Four Thousand One Hundred Eighty Four Dollars and 72/100**

Curtis Sigler

COMMUNITY BANK
PENDLETON, INDIANA

TREASURER

⑈019520⑈ ⑆074905539⑆ 59⑈3587 3⑈