



FALL CREEK REGIONAL WASTE DISTRICT

Box 44, Pendleton, Indiana 46064

*Buying from Ray Miller*

*1-8000585.00*

Nº 000035

APPLICATION FOR SEWER PERMIT

Permit No. \_\_\_\_\_ Date \_\_\_\_\_  
Permit Void 90 days from Date of Issuance  
Owner Name *Dale L. Auler*  
Property Address *705 Mainfold*  
Lot # \_\_\_\_\_ P.O. Box \_\_\_\_\_  
Town *Ingalls*, IN Zip Code *46048*  
Phone *485-7236* Water Meter *Ingalls*"  
\$ *150.00* Tap on Fee Paid  
\$ *25.00* Inspection fee paid

Application is hereby made for connection to the Fall Creek Regional Waste District Sewer System for the above listed property - Permit Type: Residential ☒, Commercial \_\_\_\_\_, Industrial \_\_\_\_\_, or Governmental/Institutional \_\_\_\_\_. User Information \_\_\_\_\_.

All workmanship and materials shall conform to the standards of the District Ordinance as described in Ordinance 84-2 and 84-3 as amended. Acceptance and approval must be made by the District inspector or his duly authorized representative before backfilling and final connection is made to the main sewer lines. Any violation of applicable regulations will cause all lines and appurtenances in violation to be removed and replaced at the owners expense.

The Fall Creek Regional Waste District is responsible for the inspection, approval of materials, and installation techniques only. All costs for materials and installation and any liabilities resulting from same is the sole responsibility of the property owner.

I have read and fully understand the above provisions and agree to comply by said provisions.


X *Dale L. Auler*  
APPLICANT(S) SIGNATURE

\*\*\*\*\*

INSPECTOR *B*  
Date inspected *10-31-85* Approved ☒ Rejected \_\_\_\_\_  
Reason for rejection \_\_\_\_\_

Date reinspected \_\_\_\_\_ Approved \_\_\_\_\_ Rejected \_\_\_\_\_

Notes:  
Size Pipe *6*"  
Type Pipe *PVC*  
Basement Yes ☒ No \_\_\_\_\_  
Sump Pump Yes \_\_\_\_\_ No ☒  
Downspout to Ground Yes ☒ No \_\_\_\_\_  
Septic Tank Pumped & filled Yes \_\_\_\_\_ No ☒  
Contractor *Kelly*  
Special Conditions *Co in Basement*

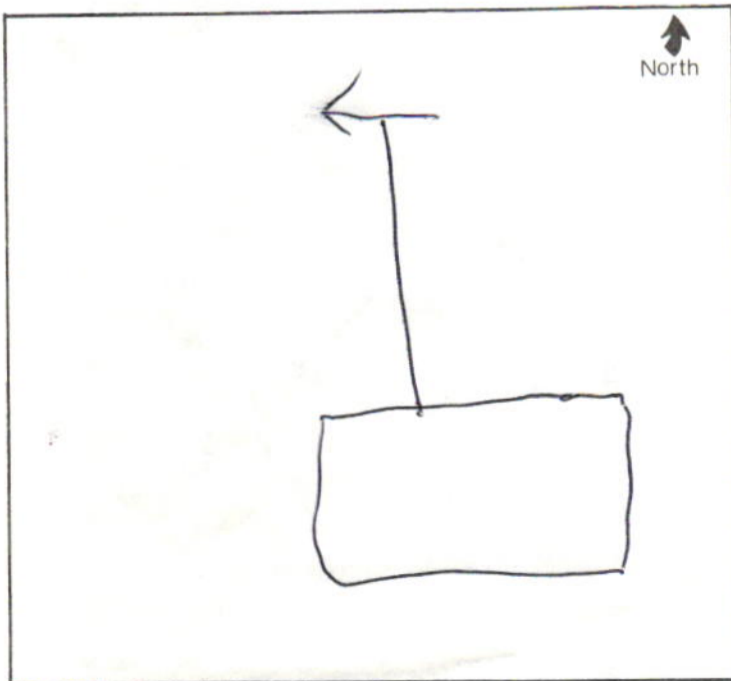



# FALL CREEK REGIONAL WASTE DISTRICT

Box 44, Pendleton, Indiana 46064

Nº 000035

## APPLICATION FOR SEWER PERMIT

Permit No. \_\_\_\_\_ Date \_\_\_\_\_  
Permit Void 90 days from Date of Issuance  
Owner Name Pete Carpenter  
Property Address 705 Norfield  
Lot # \_\_\_\_\_ P.O. Box \_\_\_\_\_  
Town Ingalls, IN Zip Code 46048  
Phone 485-7236 Water Meter Ingalls"  
\$ 150.00 Tap on Fee Paid  
\$ 25.00 Inspection fee paid

Application is hereby made for connection to the Fall Creek Regional Waste District Sewer System for the above listed property - Permit Type: Residential ☒, Commercial \_\_\_\_\_, Industrial \_\_\_\_\_, or Governmental/Institutional \_\_\_\_\_. User Information \_\_\_\_\_.

All workmanship and materials shall conform to the standards of the District Ordinance as described in Ordinance 84-2 and 84-3 as amended. Acceptance and approval must be made by the District inspector or his duly authorized representative before backfilling and final connection is made to the main sewer lines. Any violation of applicable regulations will cause all lines and appurtenances in violation to be removed and replaced at the owners expense.

The Fall Creek Regional Waste District is responsible for the inspection, approval of materials, and installation techniques only. All costs for materials and installation and any liabilities resulting from same is the sole responsibility of the property owner.

I have read and fully understand the above provisions and agree to comply by said provisions.

X Walter S. Auler  
APPLICANT(S) SIGNATURE

\*\*\*\*\*

INSPECTOR B  
Date inspected 10-31-80 Approved ☒ Rejected \_\_\_\_\_  
Reason for rejection \_\_\_\_\_

Date reinspected \_\_\_\_\_ Approved \_\_\_\_\_ Rejected \_\_\_\_\_

Notes:  
Size Pipe 6"  
Type Pipe PVC  
Basement Yes ☒ No \_\_\_\_\_  
Sump Pump Yes \_\_\_\_\_ No ☒  
Downspout to Ground Yes ☒ No \_\_\_\_\_  
Septic Tank Pumped & filled Yes \_\_\_\_\_ No ☒  
Contractor Kelly  
Special Conditions CO in Basement

