

4553

FALL CREEK REGIONAL WASTE DISTRICT

9378 S 650 WEST, P.O. BOX 59, PENDLETON, IN 46064

765-778-7544

AGREEMENT FOR SANITARY SEWER SERVICE

This Agreement made and entered into this 22ND day of January, 2002, between FALL CREEK REGIONAL WASTE DISTRICT ("District") and Mustin Block Greg Bell ("Applicant") regarding the provision of sanitary sewer service, and the assignment of capacity in, and connection to, the District's facilities for the premises located at 7098 S. Mayapple Lane 1115

NOW THEREFORE, the parties, in consideration of the mutual promises set out in this Agreement, the receipt and sufficiency of which is hereby acknowledged, agree as follows:

1. The Applicant agrees that all workmanship and materials shall conform to all District ordinances and the District's construction standards. District must accept and approve all work and materials before backfilling and final connection is made to the sewer mains. Any violation of this condition will cause all lines and appurtenances in violation to be removed and replaced at the Applicant's expense.

2. The District shall have the right to enter at any reasonable times to inspect, repair, or replace any equipment used in connection with the service for which has an impact on said service.

3. The Applicant shall be responsible for all charges, and tap fees. The failure to pay any rate charge or fee may result in a suspension and/or the termination of service to the property, the cost of which will be borne by Applicant, including, all attorney's fees and collection costs.

4. The District shall not be responsible for any damages as a result of any failure to supply service unless said damages are due to default, neglect or culpability on the part of the District.

5. If there is an available sanitary sewer within three hundred (300) feet of the property line, the property owner shall be required to connect to the District's sanitary sewer system.

6. The Applicant and District agree that the provision of sanitary sewer service touches and concerns the property and the terms of this Agreement bind the District and Applicant and their heirs, executors, administrators, personal representatives, successors, agents, attorneys, assigns, designees, and transferees.

The parties hereto have read and fully understand the above provisions and agree to comply with said provisions.

FALL CREEK REGIONAL WASTE DISTRICT
Signature Jan E. Carey

APPLICANT Edward John
Signature

STATE OF INDIANA)
COUNTY OF MADISON) SS:

SUBSCRIBED and sworn to before me this 22ND day of January, 2002

My Commission Expires:
4-29-2009

Signature Jan E. Carey
Printed Jan E. Carey
Notary Public
Resident of Madison County

INSPECTOR Steve DATE INSPECTED 2/15/02 APPROVED ✓ REJECTED _____

REASON FOR REJECTION _____

DATE REINSPECTED _____ APPROVED _____ REJECTED _____

NOTES:
SIZE PIPE 6" TYPE PIPE SDR 35

BASEMENT YES NO

SUMP PUMP YES ☒ NO

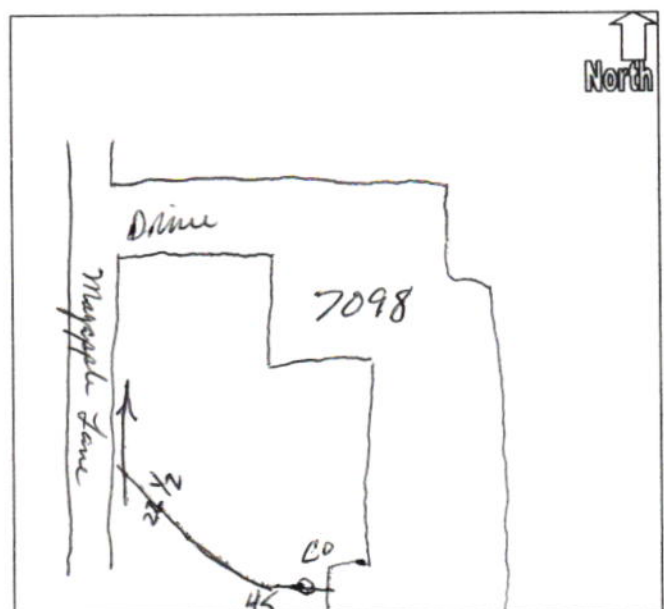
DOWNSPOUT TO GROUND YES NO

SEPTIC TANK PUMPED & FILLED YES NO

CONTRACTOR Buddy Bolton

SPECIAL CONDITIONS

EXISTING HOME

NEW CONSTRUCTION ☒

MUSTIN BUILDERS, INC.

044452

DATE	INVOICE NO.	DESCRIPTION	INVOICE AMOUNT	DEDUCTION	BALANCE
1-21-02	012100	lot 15 Trillium Woo	2556.00	.00	2556.00
CHECK DATE	1-21-02	CHECK NUMBER	44452	2556.00	.00
					2556.00

PLEASE DETACH THIS PORTION AND RETAIN FOR YOUR RECORDS



MUSTIN BUILDERS, INC.
 810 CENTRAL AVENUE
 ANDERSON, IN 46012
 PH. 765-644-8502

KEYBANK NATIONAL ASSOCIATION
 CLEVELAND, OHIO 44114

56-704-412

044452

Pay: *****Two thousand five hundred fifty-six dollars and no cents

DATE

CHECK NO.

AMOUNT

January 21, 2002

44452 \$*****2,556.00

PAY
TO THE
ORDER
OF

Fall Creek Waste Management
 P. O. Box 59
 County Road 650 West
 Pendleton, IN 46064

AUTHORIZED SIGNATURE

044452