



FALL CREEK REGIONAL WASTE DISTRICT

9378 S. 650 West PO Box 59  
Pendleton, IN 46064-0059 778-7544

add order  
on file

26-00130.00

Contractor: Source One Boring  
Indy

APPLICATION FOR SEWER PERMIT

Nº 2799

Date 6/7/00

Permit Void 90 days from Date of Issuance

Owner Name Glen Robinson

Property Address 7121 S 600 W

Lot # \_\_\_\_\_ P.O. Box \_\_\_\_\_

Town Pendleton, IN Zip Code 46064

Phone \_\_\_\_\_ City Water \_\_\_\_\_ Well ☒

\$ 2556.00 Tap on Fee Paid grinder unit pd \$1024.80

\$ N/A Inspection fee paid

Application is hereby made for connection to the Fall Creek Regional Waste District Sewer System for the above listed property - Permit Type: Residential ☒, Commercial \_\_\_\_\_, Industrial \_\_\_\_\_, or Governmental/Institutional \_\_\_\_\_. User Information \_\_\_\_\_.

All workmanship and materials shall conform to the standards of the District Ordinance as described in Ordinance 84-2 and 84-3 as amended. Acceptance and approval must be made by the District inspector or his duly authorized representative before backfilling and final connection is made to the main sewer lines. Any violation of applicable regulations will cause all lines and appurtenances in violation to be removed and replaced at the owners expense.

The Fall Creek Regional Waste District is responsible for the inspection, approval of materials, and installation techniques only. All costs for materials and installation and any liabilities resulting from same is the sole responsibility of the property owner.

I have read and fully understand the above provisions and agree to comply by said provisions.

Glen Robinson

APPLICANT(S) SIGNATURE

\*\*\*\*\*

INSPECTOR Don Ben

Date inspected 6-26-00 Approved ☒ Rejected \_\_\_\_\_

Reason for rejection \_\_\_\_\_

Date reinspected \_\_\_\_\_ Approved \_\_\_\_\_ Rejected \_\_\_\_\_

Notes:

Size Pipe 1 1/2 FM 160

Type Pipe 4" PVC 35

Basement Yes \_\_\_\_\_ No ☒

Sump Pump Yes \_\_\_\_\_ No ☒

Downspout to Ground Yes ☒ No \_\_\_\_\_


Septic Tank Pumped & filled Yes ☒ No \_\_\_\_\_

Contractor SOURCE ONE BORING

Special Conditions \_\_\_\_\_

Existing Home ☒

New Construction \_\_\_\_\_

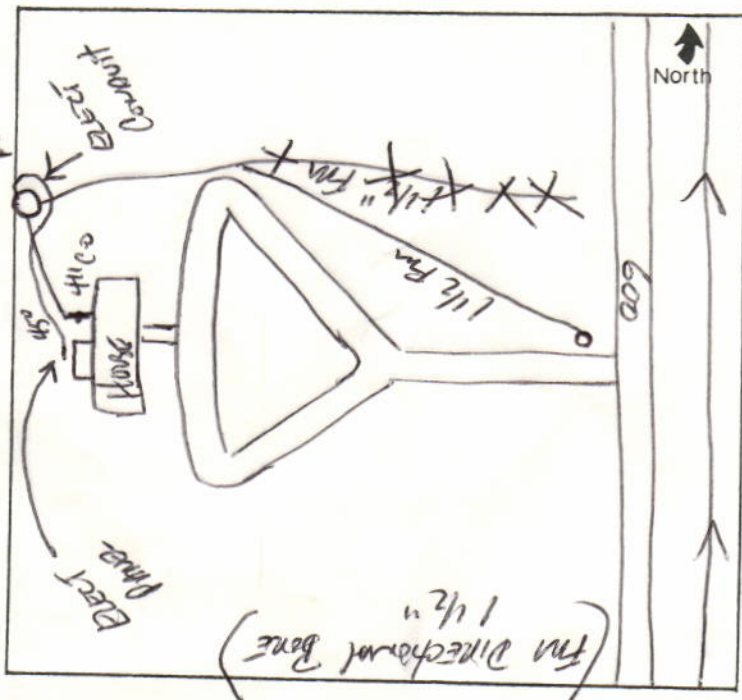

9378 S. CR 650 W.  
P.O. Box 59  
Pendleton, IN 46064  
Phone: 765-778-7544

**INVOICE**

Name	Glen Robinson	Acct #	26-00130.00
Address	7121 S 600 W		
City	Pendleton	State	IN Zip 46064
Phone			

Project Area #	D
W.O. #	9915
Due Date	90 days

QTY	DESCRIPTION	UNIT PRICE	TOTAL
1	tap fee	\$400.00	\$400.00
1	capacity fee	\$2,156.00	\$2,156.00
		Sub-Total	\$2,556.00

DATE	PAYMENT	CHECK NUMBER	AMOUNT
		<b>Sub-Total</b>	\$0.00

<b>TOTAL</b>	<b>\$2,556.00</b>
--------------	-------------------

***Detach bottom portion and return with payment***

**Cut here**

Name	Glen Robinson	Acct #	26-00130.00
Address	7121 S 600 W		
City	Pendleton	State	IN Zip 46064
Phone	0		

Project Area # D  
W.O. # 9915  
Due Date 90 days

<b>Amount Due</b>	<b>\$2,556.00</b>
-------------------	-------------------

## DAILY SUMMARY

CMD7-END

Account No 260013000 ROBINSON, GLEN

7121 S 600 W

Sel	Date	Tran Type	Total	Waste Wtr	Penalty
	3/25/99	BILLING	27.35	27.35	
	4/26/99	BILLING	54.70	54.70	
	5/19/99	BILL ADJ	.41	.41	
	5/26/99	BILLING	82.05	82.05	
	6/25/99	BILLING	109.40	109.40	
	7/26/99	BILLING	136.75	136.75	
	8/27/99	BILLING	164.10	164.10	
	9/24/99	BILLING	191.45	191.45	
	10/25/99	BILLING	218.80	218.80	
	11/24/99	BILLING	246.15	246.15	
	12/23/99	BILLING	273.50	273.50	
	1/24/00	BILLING	300.85	300.85	
	2/17/00	BILL ADJ	4.10	4.10	
	2/25/00	BILLING	328.20	328.20	
	3/24/00	BILLING	355.55	355.55	

926