



FALL CREEK REGIONAL WASTE DISTRICT

Box 44, Pendleton, Indiana 46064

3-1024 220.00

Nº 001635

APPLICATION FOR SEWER PERMIT

Permit No. _____ Date 3-14-88
Permit Void 90 days from Date of Issuance
Owner Name Claras Pizza King
Property Address St Rd 67
Lot # _____ P.O. Box _____
Town Pendleton, IN Zip Code 46064
Phone 778-3069 Water Meter _____
\$ 1500 Tap on Fee Paid
\$ 25.00 Inspection fee paid

Application is hereby made for connection to the Fall Creek Regional Waste District Sewer System for the above listed property - Permit Type: Residential _____, Commercial X, Industrial _____, or Governmental/Institutional _____. User Information _____.

All workmanship and materials shall conform to the standards of the District Ordinance as described in Ordinance 84-2 and 84-3 as amended. Acceptance and approval must be made by the District inspector or his duly authorized representative before backfilling and final connection is made to the main sewer lines. Any violation of applicable regulations will cause all lines and appurtenances in violation to be removed and replaced at the owners expense.

The Fall Creek Regional Waste District is responsible for the inspection, approval of materials, and installation techniques only. All costs for materials and installation and any liabilities resulting from same is the sole responsibility of the property owner.

I have read and fully understand the above provisions and agree to comply by said provisions.

APPLICANT(S) SIGNATURE

INSPECTOR B

Date inspected 3-4-88 Approved ✓ Rejected _____

Reason for rejection _____

Date reinspected _____ Approved _____ Rejected _____

Notes:

Size Pipe 6 "

Type Pipe PVC

Basement Yes _____ No ✓


Sump Pump Yes _____ No X

Downspout to Ground Yes X No _____

Septic Tank Pumped & filled Yes _____ No X

Contractor EARL DAVIS

Special Conditions NEW CONST

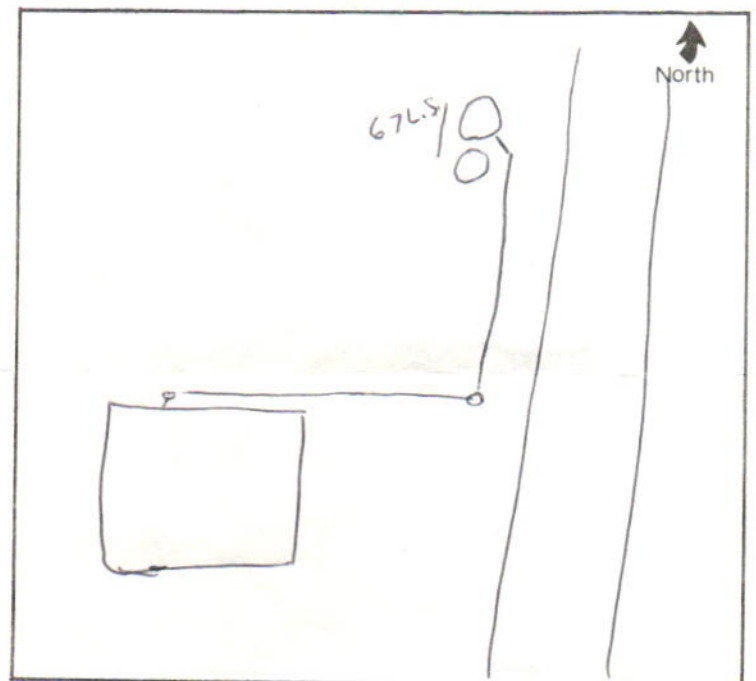



FALL CREEK REGIONAL WASTE DISTRICT

Box 59, County Road 650 West, Pendleton, Indiana, 46064 (317) 778-3983

March 14, 1988

Dave Combs
Pizza King
RR #2 Box 133C
Pendleton, IN 46064-9407

RE: Wastewater Connection
Tap-On Fee

Dear Mr. Combs:

Based on the actual cost to the District for the sewer line extension and including the capacity allocated to the interceptor and treatment facilities, the sewer tap-on fee has been established as \$1,500.00. the administrative and inspection services are an additional \$25.00, therefore the total cost for hook-up will be \$1,525.00. Please consider this letter as a claim for this amount.

Please advise any questions.

Respectfully,

Dod Nobel
General Manager

tag