



FALL CREEK REGIONAL WASTE DISTRICT

Box 44, Pendleton, Indiana 46064

2-0008480.00

Nº 000191

APPLICATION FOR SEWER PERMIT

Permit No. \_\_\_\_\_ Date 9-23-85  
Permit Void 90 days from Date of Issuance  
Owner Name Maura C. Colvill  
Property Address 7130 Ydemdricks  
Lot # \_\_\_\_\_ P.O. Box \_\_\_\_\_  
Town Anderson, IN Zip Code 46013  
Phone 643-3857 Water Meter \_\_\_\_\_"  
\$ 150.00 Tap on Fee Paid  
\$ 25.00 Inspection fee paid

Application is hereby made for connection to the Fall Creek Regional Waste District Sewer System for the above listed property - Permit Type: Residential X, Commercial \_\_\_\_\_, Industrial \_\_\_\_\_, or Governmental/Institutional \_\_\_\_\_. User Information \_\_\_\_\_.

All workmanship and materials shall conform to the standards of the District Ordinance as described in Ordinance 84-2 and 84-3 as amended. Acceptance and approval must be made by the District inspector or his duly authorized representative before backfilling and final connection is made to the main sewer lines. Any violation of applicable regulations will cause all lines and appurtenances in violation to be removed and replaced at the owners expense.

The Fall Creek Regional Waste District is responsible for the inspection, approval of materials, and installation techniques only. All costs for materials and installation and any liabilities resulting from same is the sole responsibility of the property owner.

I have read and fully understand the above provisions and agree to comply by said provisions.


X Maura C. Colvill - Berleah Hall  
APPLICANT(S) SIGNATURE

\*\*\*\*\*

INSPECTOR Tim  
Date inspected 12-12-88 Approved X Rejected \_\_\_\_\_  
Reason for rejection \_\_\_\_\_

Date reinspected \_\_\_\_\_ Approved \_\_\_\_\_ Rejected \_\_\_\_\_

Notes:  
Size Pipe 6""  
Type Pipe PVC  
Basement Yes \_\_\_\_\_ No X  
Sump Pump Yes \_\_\_\_\_ No X  
Downspout to Ground Yes X No \_\_\_\_\_  
Septic Tank Pumped & filled Yes X No \_\_\_\_\_  
Contractor A&A  
Special Conditions \_\_\_\_\_

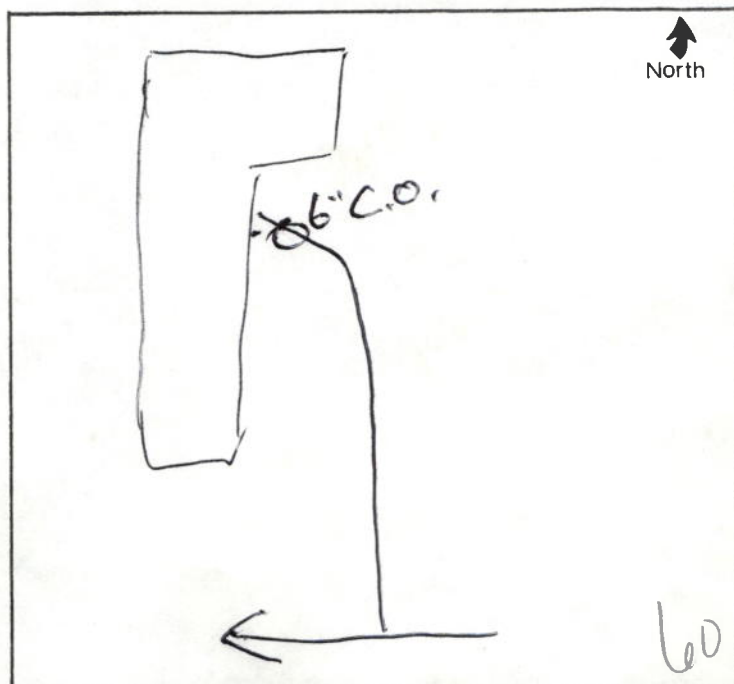



NO 000101

4-23-82

David B. Brown  
1130 1st Ave N

8:00 AM

1130-3825

32


Mr. Brown,  
I am writing to you regarding the waste disposal site located on the north side of the city of Pocatello. The site is currently being used for the disposal of solid waste and is a source of odor and visual blight. The waste district is planning to develop a new waste transfer station and landfill on the south side of the city. This new facility will provide a more sanitary and efficient method of waste disposal and will eliminate the problems associated with the current site. We are currently in the process of obtaining the necessary permits and funding for the new facility. We hope to have it operational within the next few years. We appreciate your understanding and support of this project.

Sincerely,  
[Signature]

Enclosed for you is a copy of the waste management plan for the new facility. Please review it and let me know if you have any questions or comments.

Very truly yours,  
[Signature]

cc: [Name]

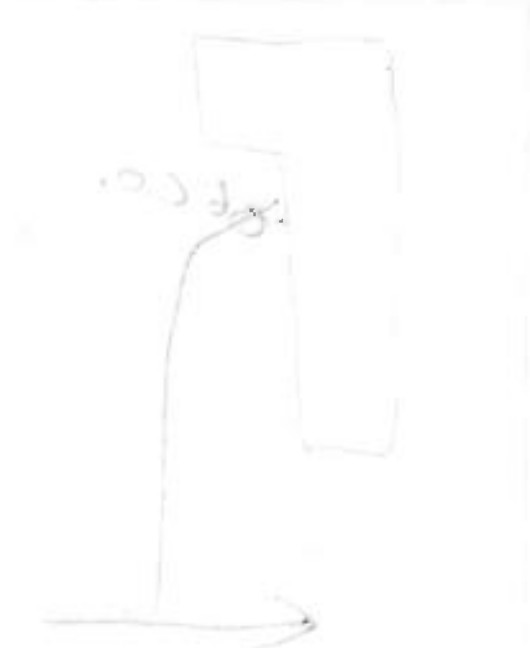

1130-3825  
151566  
MBA