



FALL CREEK REGIONAL WASTE DISTRICT

9378 S. 650 West PO Box 59
Pendleton, IN 46064-0059 778-7544

add order
on file

22-24025.00

builder: Eagle Creston Homes
2904 485-5786

APPLICATION FOR SEWER PERMIT

No 2767

Date 4/27/00

Permit Void 90 days from Date of Issuance

Owner Name Brian & Leanna Cobb

Property Address 7131 S Trillium Trail

Lot # 6, Trillium Woods P.O. Box

Town Pendleton, IN Zip Code 46064

Phone City Water Well ☒

\$ 400 Tap on Fee Paid

\$ 2156 capacity Inspection fee paid

Application is hereby made for connection to the Fall Creek Regional Waste District Sewer System for the above listed property - Permit Type: Residential ☒, Commercial ☐, Industrial ☐, or Governmental/Institutional ☐. User Information

All workmanship and materials shall conform to the standards of the District Ordinance as described in Ordinance 84-2 and 84-3 as amended. Acceptance and approval must be made by the District inspector or his duly authorized representative before backfilling and final connection is made to the main sewer lines. Any violation of applicable regulations will cause all lines and appurtenances in violation to be removed and replaced at the owners expense.

The Fall Creek Regional Waste District is responsible for the inspection, approval of materials, and installation techniques only. All costs for materials and installation and any liabilities resulting from same is the sole responsibility of the property owner.

I have read and fully understand the above provisions and agree to comply by said provisions.

[Signature]

APPLICANT(S) SIGNATURE

INSPECTOR *[Signature]*

Date inspected 4-27-00 Approved ☒ Rejected ☐

Reason for rejection

Date reinspected Approved Rejected

Notes:

Size Pipe 6"

Type Pipe PVC

Basement Yes No ☒

Sump Pump Yes No ☒

Downspout to Ground Yes ☒ No


Septic Tank Pumped & filled Yes No ☒

Contractor D+R

Special Conditions

Existing Home

New Construction ☒

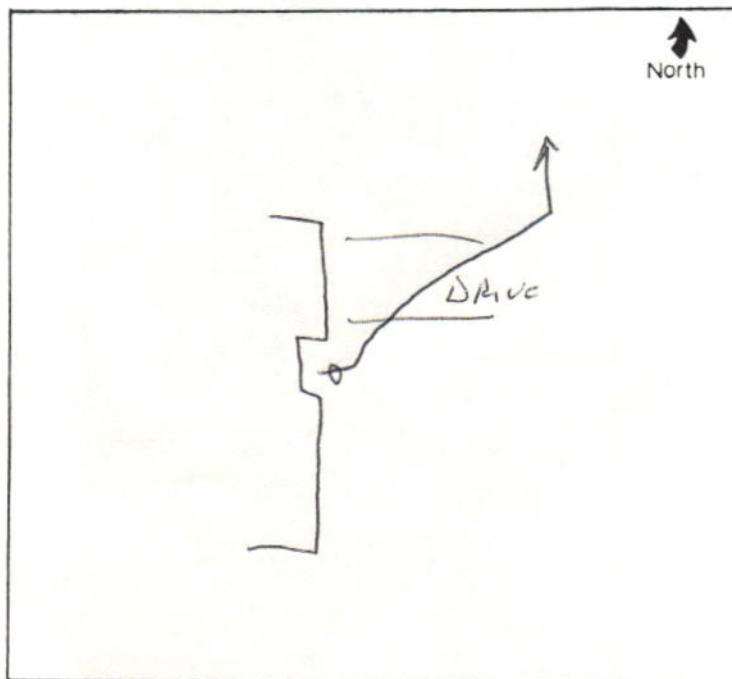



EAGLE CUSTOM HOMES, LLC
PO BOX 502687
INDIANAPOLIS, IN 46250

1041

20-6/740 150

Date 4-27-00

Pay to the
Order of

Fall Creek Waste Water District

\$ 2,556.00

Two thousand five hundred fifty six and 00/100

Dollars Security features included. Details on back.

National City.

National City Bank of Indiana
Indianapolis, Indiana

For

lot 6 Trillium Woods

Lindy & Julie

MP

⑈001041⑈ ⑆074000065⑆