

Gidw.

PROJECT Phase II SHEET _____ OF _____

SUBJECT _____ DATE 6-18-18


JOB NO. 4447

BY At/As

713 S. Center

← N

laterals 713 & 725 in
the same trench

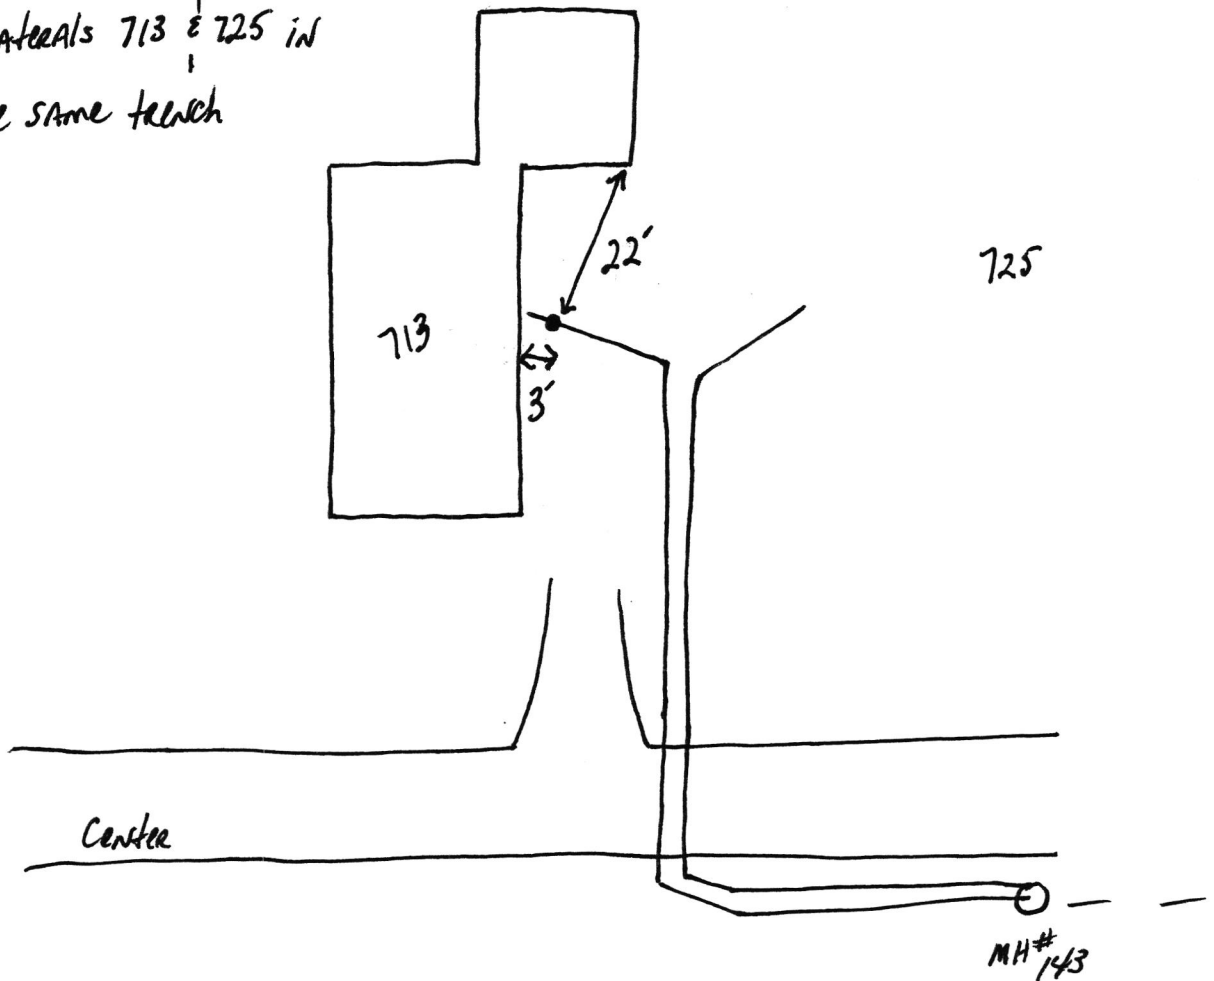

713 Center ST

SMP Phase II

6.19.18

