


Gidw.

PROJECT Phase II SHEET _____ OF _____
SUBJECT _____ DATE 6-15-18
JOB NO. 4447
BY AHAS

713 S. Silver

← N

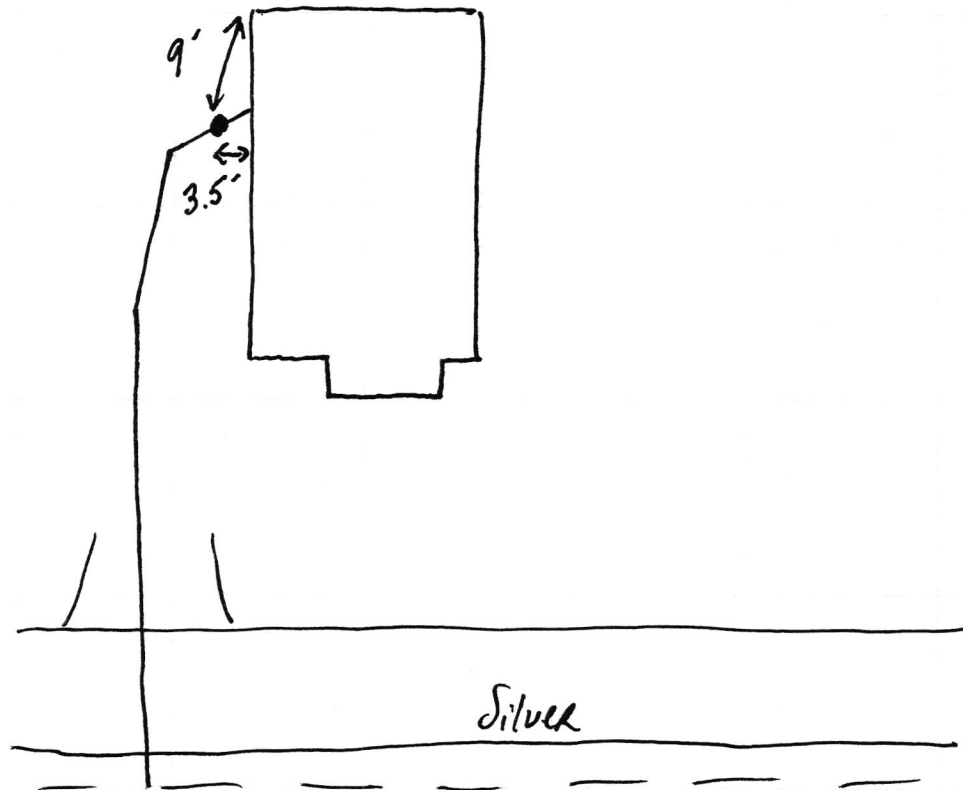

713 Silver

SRF Phase II

6.19.18

