

4647

9378 S 650 WEST, P.O. BOX 59, PENDLETON, IN 46064

765-778-7544

AGREEMENT FOR SANITARY SEWER SERVICE

This Agreement made and entered into this 16th day of Sept., 2002, between FALL CREEK REGIONAL WASTE DISTRICT ("District") and Doretta Chambers ("Applicant") regarding the provision of sanitary sewer service, and the assignment of capacity in, and connection to, the District's facilities for the premises located at 7144 W. Fall Creek Dr, Pendleton

NOW THEREFORE, the parties, in consideration of the mutual promises set out in this Agreement, the receipt and sufficiency of which is hereby acknowledged, agree as follows:

1. The Applicant agrees that all workmanship and materials shall conform to all District ordinances and the District's construction standards. District must accept and approve all work and materials before backfilling and final connection is made to the sewer mains. Any violation of this provision will cause all lines and appurtenances in violation to be removed and replaced at the Applicant's expense.
2. The District shall have the right to enter upon the Applicant's premises at all reasonable times to inspect, repair, or replace any equipment used in connection with the District's service or which has an impact on said service.
3. The Applicant shall be responsible for all monthly user rates, capacity charges, and tap fees. The failure to pay any rate charge or fee may result in a lien against the property and/or the termination of service to the property, the cost of which will be borne by Applicant, including, but not limited to, all attorney's fees and collection costs.
4. The District shall not be responsible for any damages as a result of any failure to supply service unless said damages are due to default, neglect or culpability on the part of the District.
5. If there is an available sanitary sewer within three hundred (300) feet of the property line, the property owner shall be required to connect to the District's sanitary sewer system.
6. The Applicant and District agree that the provision of sanitary sewer service touches and concerns the property and the terms of this Agreement bind the District and Applicant and their heirs, executors, administrators, personal representatives, successors, agents, attorneys, assigns, designees, and transferees.

The parties hereto have read and fully understand the above provisions and agree to comply with said provisions.

FADL CREEK REGIONAL WASTE DISTRICT

Signature _____

APPLICANT

Signature _____

STATE OF INDIANA)
) SS:
COUNTY OF MADISON)

SUBSCRIBED and sworn to before me this 16th day of Sept., 2002.

My Commission Expires:

My Commission
4-29-09

Signature _____

Printed

Notary Public

Resident of Madison County

INSPECTOR DATE INSPECTED 9-30-22 APPROVED REJECTED

REASON FOR REJECTION

DATE REINSPECTED _____ APPROVED _____ REJECTED _____

NOTES:

SIZE PIPE 8 - 1.5 TYPE PIPE 100

BASEMENT YES NO ☒

SUMP PUMP YES NO ☒

DOWNSPOUT TO GROUND YES^x NO


SEPTIC TANK PUMPED & FILLED YES NO

CONTRACTOR Sweet's

SPECIAL CONDITIONS

EXISTING HOME ☒

NEW CONSTRUCTION

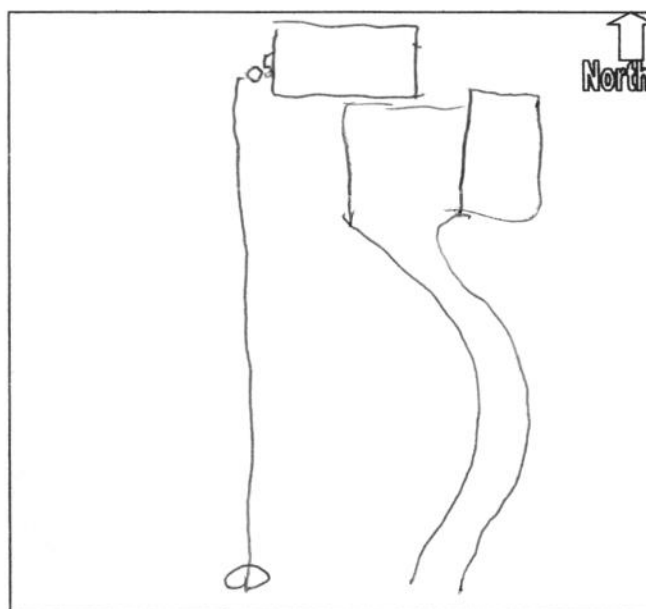

JAMES W. LUKE 2-88
LORETTA CHAMBERS
7144 W FALL CREEK DR PH 778-4394
PENDLETON, IN 46064

3319

9/16/02 DATE

71-553/749
BRANCH 2

PAY TO THE ORDER OF FCRWD

\$ 3659. ⁸⁰/₁₀₀

Three Thousand, Six Hundred, Fifty-Nine ⁸⁰/₁₀₀ DOLLARS

Security
Features
Details on
Back



Madison
Community Bank

The
CLASSIC

FOR

Sewer Hook-up

Loretta M Chambers

⑆074905539⑆ 595 922 5⑈ 3319

© HARLAND 2000



FALL CREEK REGIONAL WASTE DISTRICT

P.O. Box 59 • 9378 S. 650 West • Pendleton, Indiana 46064-0059 • (765) 778-7544

August 23, 2004

Ms. Loretta Chambers
7144 W Fall Creek Drive
Pendleton, IN 46064

Dear Ms. Chambers:

Recently the Fall Creek Regional Waste District (FCRWD) was pleased to announce that a Community Focus Fund Grant has been awarded to the Town of Ingalls with FCRWD as a sub recipient by the Indiana Department of Commerce to fund construction of a wastewater collection system for the areas of Green Township known as County Roads 650 West, 750 West, 760 West, 900 South, 920 South, 800 West, 800 South, 875 South, Fall Creek Drive (between CR 650 W and CR 750 W), and Carefree Community Homes.

As Fall Creek Regional Waste District promised and as a result of the grant, residents in these areas will not be charged any connection fees and will be provided a residential wastewater grinder unit at no cost when they connect their homes to the sanitary system.

Enclosed please find a check in the amount of \$3,659.80 as reimbursement of your connection fees and the cost of your wastewater grinder unit.

Thank you for your support of our successful grant efforts.

Sincerely,

Teresa K. Hutton
Office Manager

DATE

REFERENCE / INVOICE NO.

APV NUMBER

INVOICE AMOUNT

BALANCE

8/23/04

refund of connection fees & grinder
per Grant agreement

\$3,659.80

Tap Fee	\$475.00
Capacity Fee	\$2160.00
Grinder	\$976.00
Tax	\$48.80

DETACH AND RETAIN FOR YOUR RECORDS

THIS WARRANT VOID TWO (2)
YEARS AFTER DEC. 31 OF
THE YEAR OF ISSUE

FORM APPROVED BY STATE BOARD OF ACCOUNTS FOR FALL CREEK REGIONAL WASTE DISTRICT - 1988

FALL CREEK REGIONAL WASTE DISTRICT

PENDLETON, INDIANA 46064

71-553/749

019413

PAY TO THE ORDER OF

DATE

CHECK NUMBER

FUND

PAY EXACTLY

8/23/04


19413

100

\$3,659.80

*Three Thousand Six Hundred Fifty Nine Dollars and 80/100

Loretta Chambers

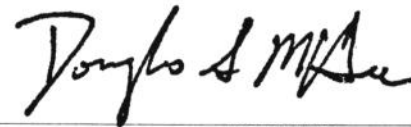MADISON COMMUNITY BANK
PENDLETON, INDIANA

TREASURER

⑈019413⑈ ⑆074905539⑆ 59⑈3587 3⑈

KOMPULROL AP VENDOR

BOYCE FORMS • SYSTEMS 1-800-382-8702 27044