



FALL CREEK REGIONAL WASTE DISTRICT

9378 S. 650 West PO Box 59
Pendleton, IN 46064-0059 778-7544

26-00150.00

APPLICATION FOR SEWER PERMIT

No 2891

Date OCT, 11 2000

Permit Void 90 days from Date of Issuance

Owner Name Brad Spitznagle

Property Address 7171 S. 600 W.

Lot # _____ P.O. Box _____

Town Pendleton, IN Zip Code IN

Phone 46064 City Water _____ Well ☒

\$ 2556.00 Tap on Fee Paid

\$ _____ ~~inspection fee paid~~

Application is hereby made for connection to the Fall Creek Regional Waste District Sewer System for the above listed property - Permit Type: Residential ☒, Commercial _____, Industrial _____, or Governmental/Institutional _____. User Information _____.

All workmanship and materials shall conform to the standards of the District Ordinance as described in Ordinance 84-2 and 84-3 as amended. Acceptance and approval must be made by the District inspector or his duly authorized representative before backfilling and final connection is made to the main sewer lines. Any violation of applicable regulations will cause all lines and appurtenances in violation to be removed and replaced at the owners expense.

The Fall Creek Regional Waste District is responsible for the inspection, approval of materials, and installation techniques only. All costs for materials and installation and any liabilities resulting from same is the sole responsibility of the property owner.

I have read and fully understand the above provisions and agree to comply by said provisions.

Brad Spitznagle

APPLICANT(S) SIGNATURE

INSPECTOR Tim

Date inspected 8-1-2000 Approved ☒ Rejected _____

Reason for rejection ?

Date reinspected _____ Approved _____ Rejected _____

Notes:

Size Pipe 4"

Type Pipe SDR 35

Basement Yes _____ No ☒

Sump Pump Yes _____ No ☒

Downspout to Ground Yes ☒ No _____


Septic Tank Pumped & filled Yes ☒ No _____

Contractor Self

Special Conditions _____

Existing Home _____

New Construction _____

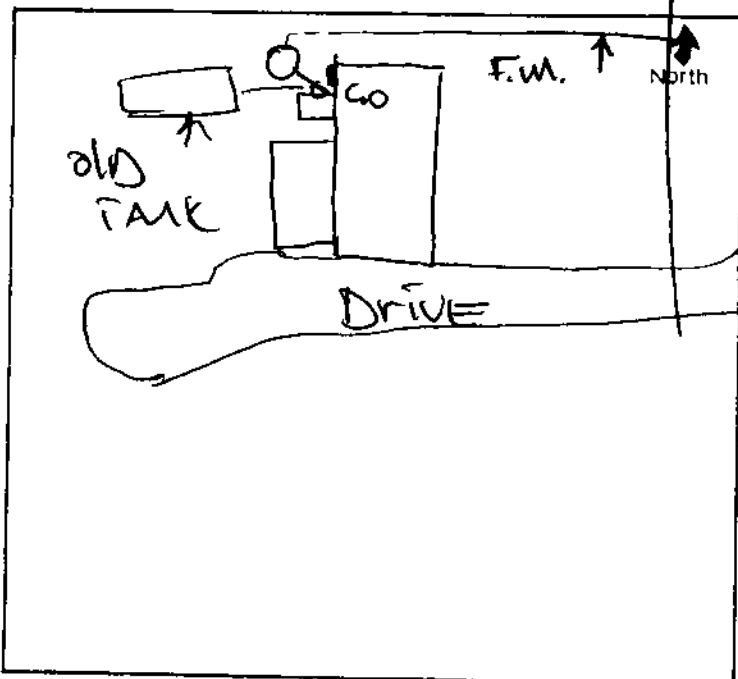

MR. & MRS. BRADLEY W. SPITZNAGLE
7171 S. 600 W.
PENDLETON, IN 46064
PH 317-778-2976

1590

20-7404/2740
BRANCH 10

Oct 11 3000

PAY TO THE ORDER OF FCRWD \$ 2,556.00

Two Thousand Five Hundred Fifty Six & — ⁰⁰/₁₀₀ DOLLARS

INDIANA
Federal Credit Union
Indianapolis, Indiana

FOR Sewer

Bradley W. Spitznagle

⑆ 274074040⑆

1590

CHARLAND 1990

9378 S. CR 650 W.
P.O. Box 59
Pendleton, IN 46064
Phone: 765-778-7544

INVOICE

Name	Bradley Spitznagle	Acct #	26-00150.00
Address	7171 S 600 W		
City	Pendleton	State	IN Zip 46064
Phone			

QTY	DESCRIPTION	UNIT PRICE	TOTAL
1	tap fee	\$400.00	\$400.00
1	capacity fee	\$2,156.00	\$2,156.00
		Sub-Total	\$2,556.00

DATE	PAYMENT	CHECK NUMBER	AMOUNT
		Sub-Total	\$0.00

Detach bottom portion and return with payment

Cut here

Name	Bradley Spitznagle	Acct #	26-00150.00
Address	7171 S 600 W		
City	Pendleton	State	IN Zip 46064
Phone	0		

Project Area # D
W.O. # 9915
Due Date 90 days

Amount Due	\$2,556.00
-------------------	-------------------

DAILY SUMMARY

CMD7-END

Account No 260015000 SPITZNAGLE, BRADLEY 7171 S 600 W

Sel	Date	Tran Type	Total	Waste Wtr	Penalty
	3/25/99	BILLING	27.35	27.35	
	4/26/99	BILLING	54.70	54.70	
	5/19/99	BILL ADJ	.41	.41	
	5/26/99	BILLING	82.05	82.05	
	6/25/99	BILLING	109.40	109.40	
	7/26/99	BILLING	136.75	136.75	
	8/27/99	BILLING	164.10	164.10	
	9/24/99	BILLING	191.45	191.45	
	10/25/99	BILLING	218.80	218.80	
	11/24/99	BILLING	246.15	246.15	
	12/23/99	BILLING	273.50	273.50	
	1/24/00	BILLING	300.85	300.85	
	2/17/00	BILL ADJ	4.10	4.10	
	2/25/00	BILLING	328.20	328.20	
	3/24/00	BILLING	355.55	355.55	

4/2/00