

GISW.


PROJECT Phase II- SHEET _____ OF _____

SUBJECT _____ DATE 5-10-18

JOB NO. 4447

BY Atlas

720 S. BROADWAY

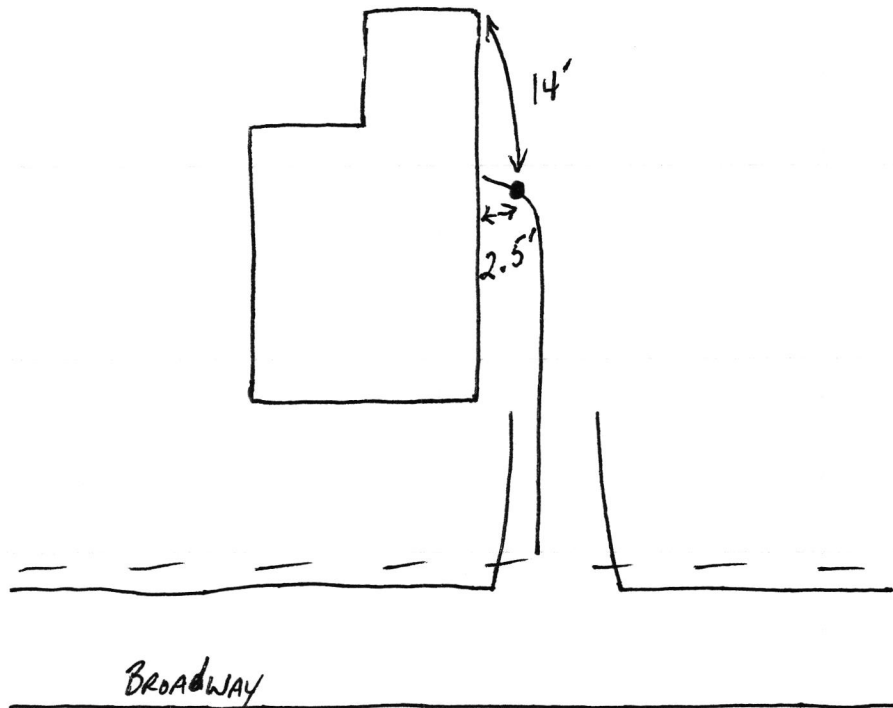

720 S Broadway

SRF Phase II

5.22.18

