



FALL CREEK REGIONAL WASTE DISTRICT

9378 S. 650 West PO Box 59
Pendleton, IN 46064-0059 778-7544

26-00190.00

APPLICATION FOR SEWER PERMIT

No 2828

Date

6/29/00

Permit Void 90 days from Date of Issuance

Owner Name

Everett Stamper

Property Address

7242 S 600 W

Lot #

P.O. Box

Town

Pendleton

IN Zip Code

46064

Phone

City Water

Well

✓

\$ 2556.00 Tap on Fee Paid

grinder unit pd \$1024.80

\$ N/A Inspection fee paid

Application is hereby made for connection to the Fall Creek Regional Waste District Sewer System for the above listed property - Permit Type: Residential ☒, Commercial ☐, Industrial ☐, or Governmental/Institutional ☐. User Information

All workmanship and materials shall conform to the standards of the District Ordinance as described in Ordinance 84-2 and 84-3 as amended. Acceptance and approval must be made by the District inspector or his duly authorized representative before backfilling and final connection is made to the main sewer lines. Any violation of applicable regulations will cause all lines and appurtenances in violation to be removed and replaced at the owners expense.

The Fall Creek Regional Waste District is responsible for the inspection, approval of materials, and installation techniques only. All costs for materials and installation and any liabilities resulting from same is the sole responsibility of the property owner.

I have read and fully understand the above provisions and agree to comply by said provisions.

APPLICANT(S) SIGNATURE

INSPECTOR

B

Date inspected 6-20-01

Approved

✓

Rejected

Reason for rejection

Date reinspected

Approved

Rejected

Notes:

Size Pipe 4 / 1 1/4 "

Type Pipe 35 / 160

Basement Yes ☒ No

Sump Pump Yes ☒ No

Downspout to Ground Yes ☒ No

Septic Tank Pumped & filled Yes ☒ No


Contractor Self

Special Conditions

Existing Home ☒

New Construction

North

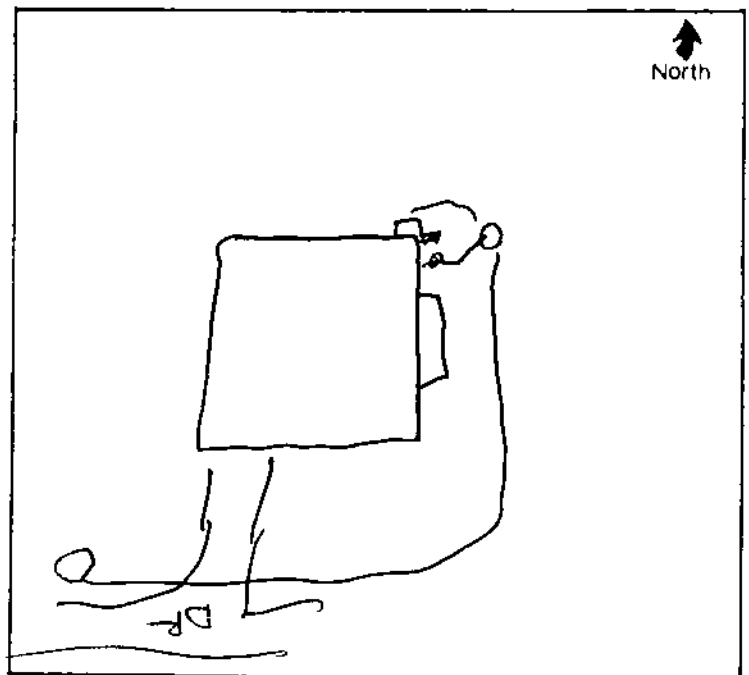



STAMPCO CONSTRUCTION, INC.
7242 S 600 W
PENDLETON, IN 46064
PH. 765-778-2206

PENDLETON BANKING COMPANY
71-553/749

5953

6/28/2000

PAY TO THE ORDER OF Fall Creek Regional Waste District

\$ **3,580.80

Three Thousand Five Hundred Eighty and 80/100*****

DOLLARS

Fall Creek Regional Waste District
PO Box 59
Pendleton, In 46064

EVERETT
STAMPER, PRESIDENT

Everett Stamer

MEMO:

⑈005953⑈ ⑆074905539⑆

SECURITY FEATURES: MICRO PRINT TOP & BOTTOM BORDERS COLORED PATTERN ARTIFICIAL WATERMARK ON REVERSE SIDE MISSING FEATURE INDICATES A COPY