

Side

PROJECT Phase II SHEET _____ OF _____


SUBJECT _____ DATE 6-18-18

JOB NO. 4447

BY Atlas

725 S. Center

← N

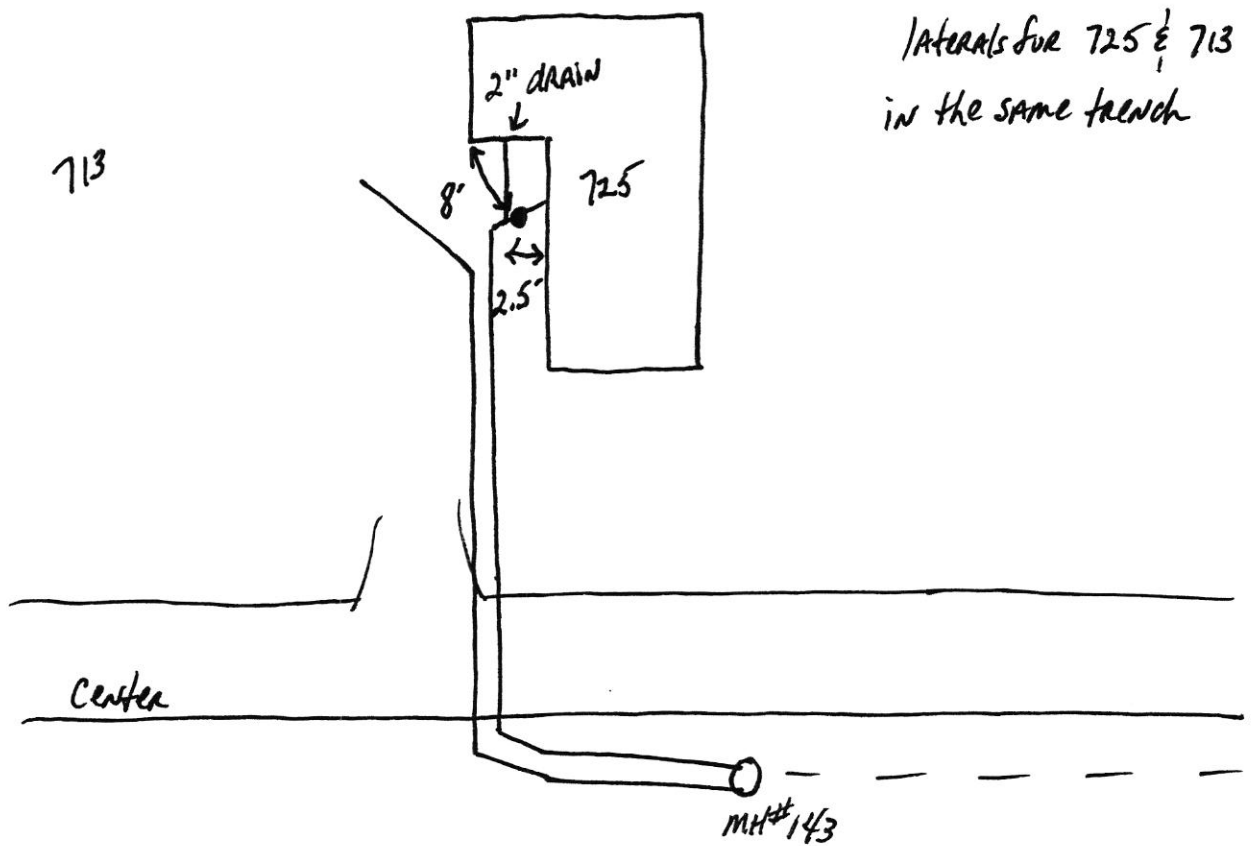

705 Center

SRF Phase II

6.19.18

