

Gidw.


PROJECT Phase II SHEET _____ OF _____

SUBJECT _____ DATE 5-10-18

JOB NO. 4447

BY Atlas

725 S. Broadway

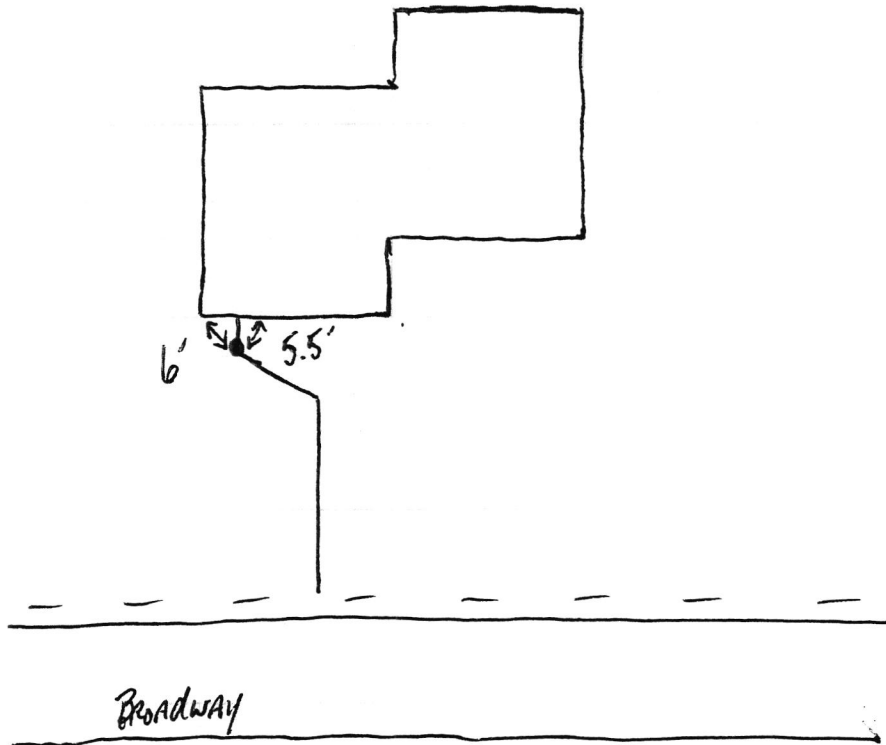

735 S Broadway

SRF Phase II

5-14-18

