

**Gidw.**


PROJECT Phase II SHEET \_\_\_\_\_ OF \_\_\_\_\_

SUBJECT \_\_\_\_\_ DATE 5-14-18

JOB NO. 4447

BY Atlas

728 S. Broadway

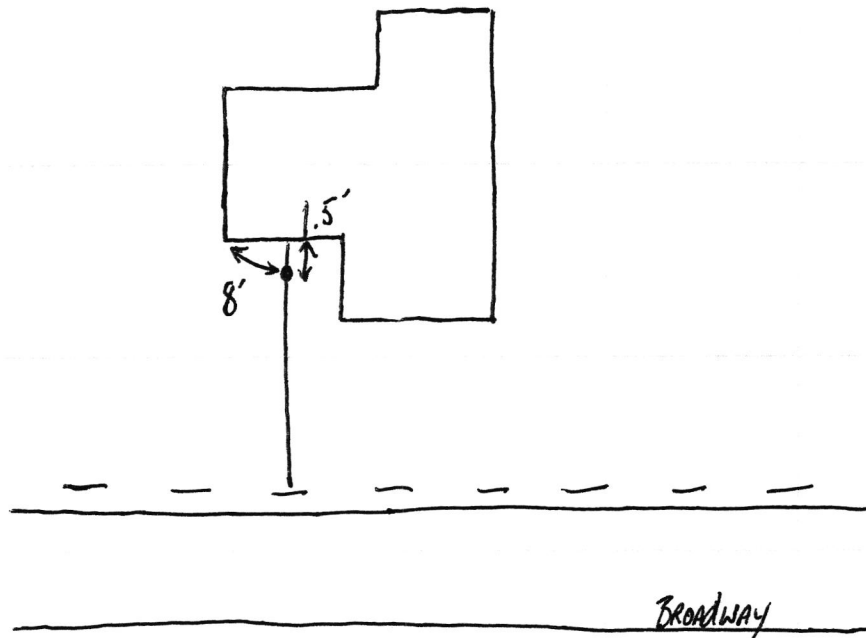

W & S Broadway

SRC Phase II

5.22.18

