



FALL CREEK REGIONAL WASTE DISTRICT

9378 S. 650 West PO Box 59
Pendleton, IN 46064-0059 778-7544

add order
on file

21-00089.00

APPLICATION FOR SEWER PERMIT

Nº 2292

Date 10-11-95

Permit Void 90 days from Date of Issuance

Owner Name Kelly Fowler

Property Address 729 N. EAST St

Lot # P.O. Box

Town Ingalls, IN Zip Code 46048

Phone City Water Well

\$ 2700.00 Tap on Fee Paid

\$ 25.00 Inspection fee paid

Application is hereby made for connection to the Fall Creek Regional Waste District Sewer System for the above listed property - Permit Type: Residential ☒, Commercial ☐, Industrial ☐, or Governmental/Institutional ☐. User Information

All workmanship and materials shall conform to the standards of the District Ordinance as described in Ordinance 84-2 and 84-3 as amended. Acceptance and approval must be made by the District inspector or his duly authorized representative before backfilling and final connection is made to the main sewer lines. Any violation of applicable regulations will cause all lines and appurtenances in violation to be removed and replaced at the owners expense.

The Fall Creek Regional Waste District is responsible for the inspection, approval of materials, and installation techniques only. All costs for materials and installation and any liabilities resulting from same is the sole responsibility of the property owner.

I have read and fully understand the above provisions and agree to comply by said provisions.

Kelly J. Fowler Sr -
APPLICANT(S) SIGNATURE

INSPECTOR F.S

Date inspected 11/16/95 Approved ☒ Rejected ☐

Reason for rejection

Date reinspected Approved Rejected

Notes:

Size Pipe 6" "

Type Pipe PVC

Basement Yes ☒ No ☐

Sump Pump Yes ☒ No ☐

Downspout to Ground Yes No


Septic Tank Pumped & filled Yes No

Contractor E DAVIS

Special Conditions

Existing Home

New Construction ☒

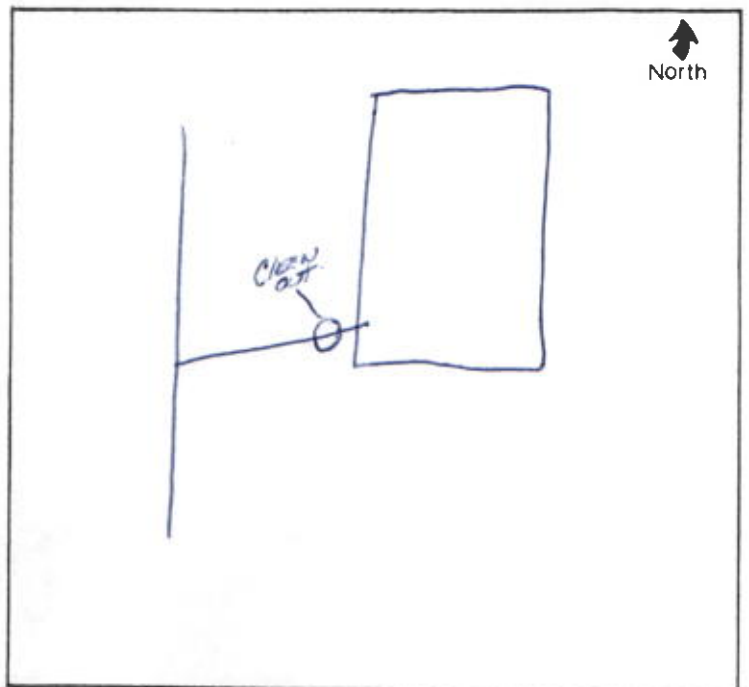

North