

Gidw.

PROJECT

Phase II

SHEET

OF

SUBJECT

DATE

6-15-18

JOB NO


4447

BY

A-Has

729 S. Silver

← N

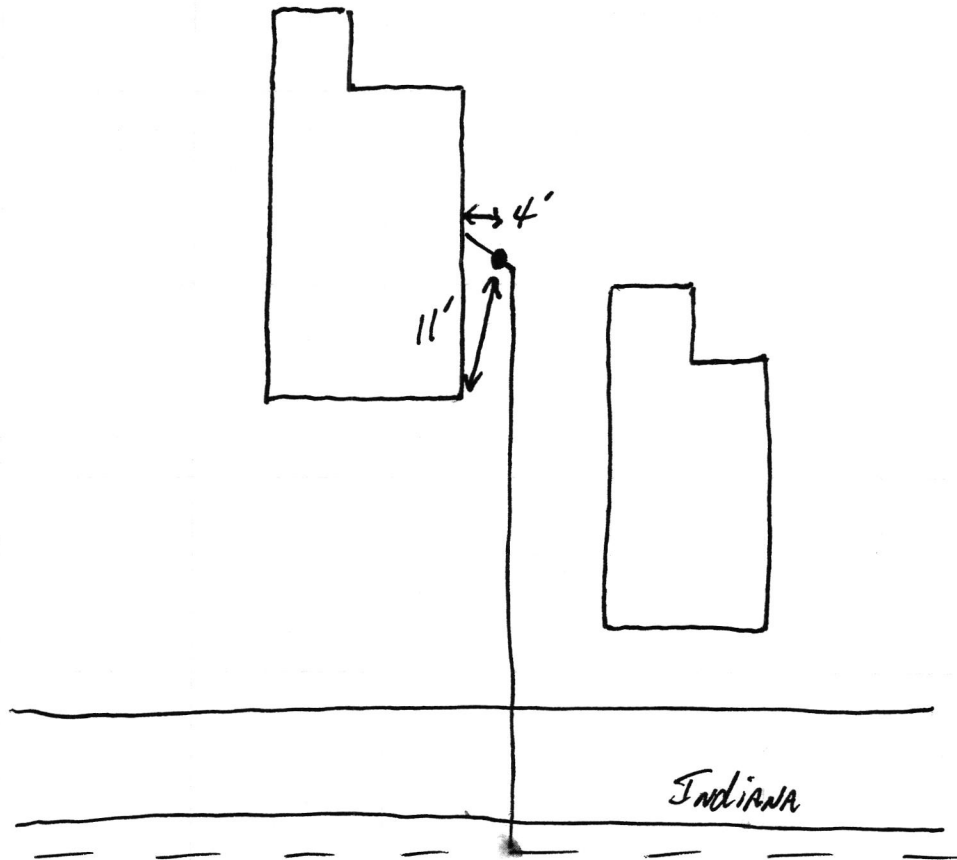

7a9 Silver

SQF Phase II

6.19.18

