

Gidw.


PROJECT Phase II SHEET _____ OF _____

SUBJECT _____ DATE 5-14-18

JOB NO. 4447

BY ALIAS

732 S. BROADWAY

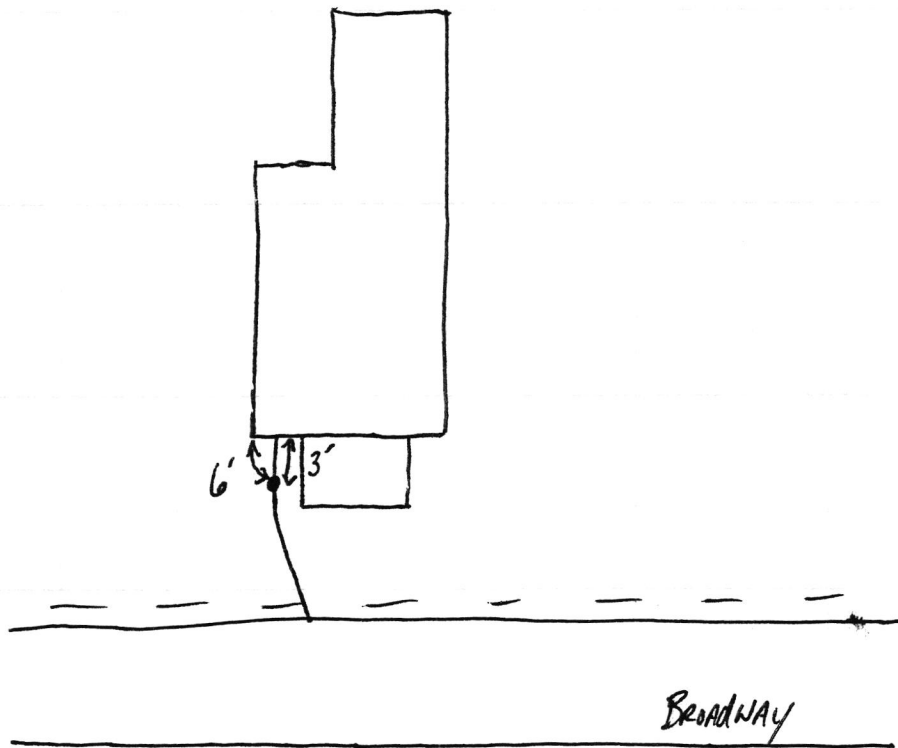

132 S Broadway

Sht Phase II

5.22.18

