


GIS

PROJECT Phase II SHEET _____ OF _____
SUBJECT _____ DATE 6-13-18
JOB NO. 4447
BY Atlas

733 S. Center

← N

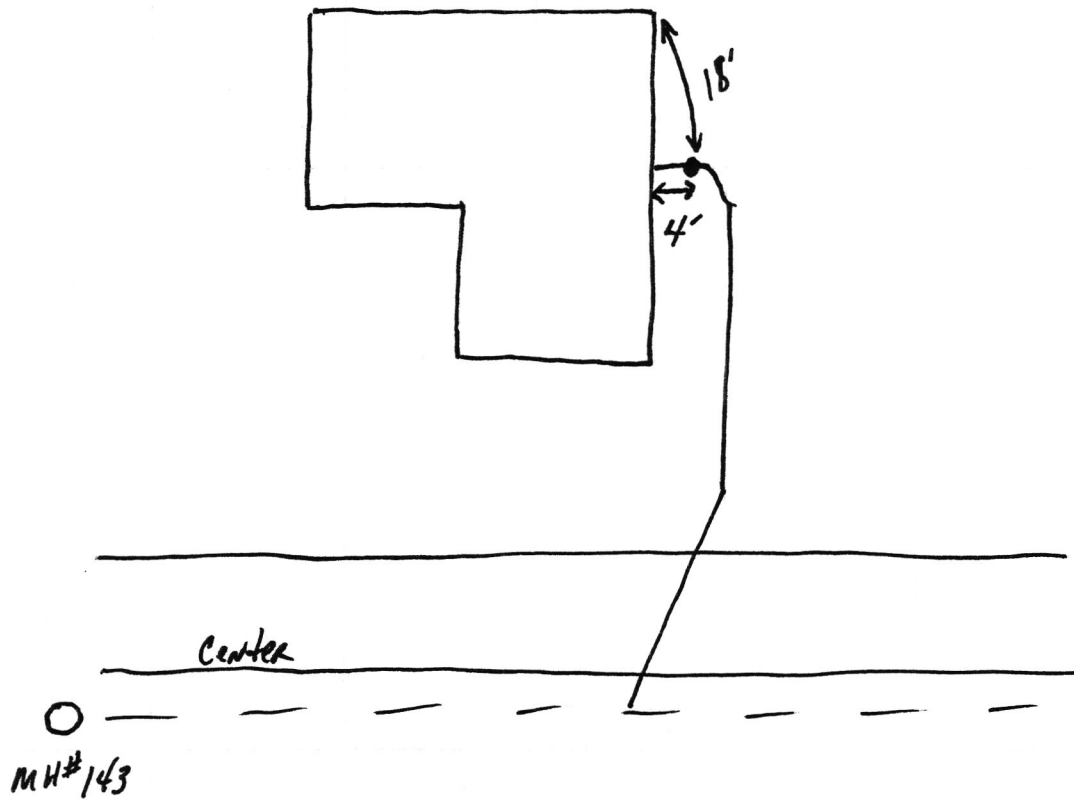

733 Center

SAC Phase II

6.19.18

