



FALL CREEK REGIONAL WASTE DISTRICT

Box 44, Pendleton, Indiana 46064

21-03120.00

2103120.00

APPLICATION FOR SEWER PERMIT

Nº 001836

Permit No. _____ Date 3/12/92

Permit Void 90 days from Date of Issuance

Owner Name Crystal Pacanowski (Dave)

Property Address 7360 W Reformatory Road

Lot # 10 P.O. Box _____

Town Ellettsville IN Zip Code 46040

Phone _____ Water Meter _____

\$ 700.00 Tap on Fee Paid

\$ 25.00 Inspection fee paid

\$200.00 refunded 2/17/95

Application is hereby made for connection to the Fall Creek Regional Waste District Sewer System for the above listed property - Permit Type: Residential ☒, Commercial _____, Industrial _____, or Governmental/Institutional _____. User Information _____

All workmanship and materials shall conform to the standards of the District Ordinance as described in Ordinance 84-2 and 84-3 as amended. Acceptance and approval must be made by the District inspector or his duly authorized representative before backfilling and final connection is made to the main sewer lines. Any violation of applicable regulations will cause all lines and appurtenances in violation to be removed and replaced at the owners expense.

The Fall Creek Regional Waste District is responsible for the inspection, approval of materials, and installation techniques only. All costs for materials and installation and any liabilities resulting from same is the sole responsibility of the property owner.

I have read and fully understand the above provisions and agree to comply by said provisions.

Crystal Pacanowski
APPLICANT(S) SIGNATURE

INSPECTOR B
Date inspected 3-12-92 Approved ☒ Rejected _____


Reason for rejection _____

Date reinspected _____ Approved _____ Rejected _____

Notes:
Size Pipe 6 "
Type Pipe PVC
Basement Yes _____ No ☒
Sump Pump Yes _____ No ☒
Downspout to Ground Yes ☒ No _____
Septic Tank Pumped & filled Yes _____ No ☒
Contractor Paul The Const
Special Conditions New Const

Lateral installed Before Main Line
Main line to be installed next week

Hooked-up
and approved
4-23-92

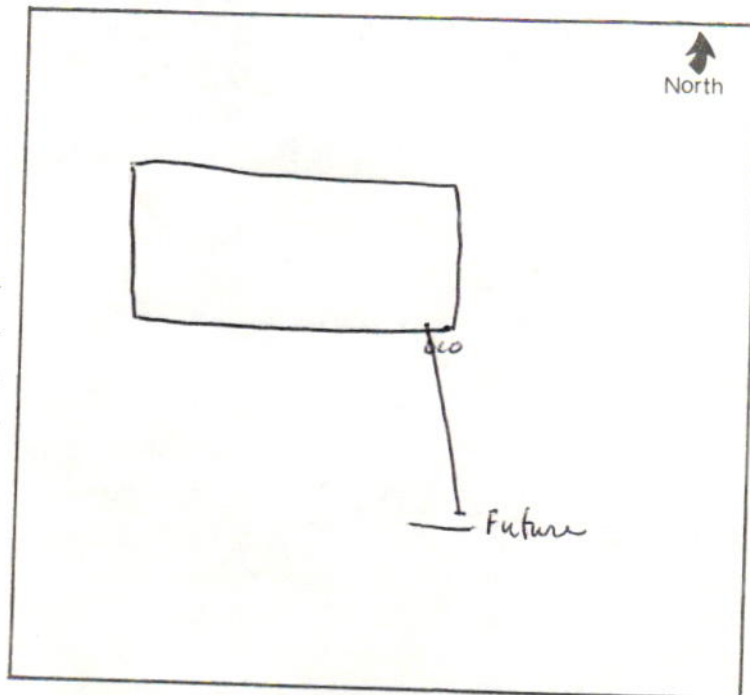



FALL CREEK REGIONAL WASTE DISTRICT

P.O. Box 59 • 9378 S. 650 West • Pendleton, Indiana 46064-0059 • (317) 778-7544

February 15, 1995

Crystal Pacanowski
7360 W Reformatory Road
Fortville, IN 46040

Dear Ms. Pacanowski:

After looking over our records, we have found that you overpaid your tap fee by \$200.00. Enclosed you will find a pink claim form. Please sign the form and return it in the enclosed envelope and we will issue you a refund check.

Please give us a call at 317-778-7544 if you have any questions.

Respectfully,

Debbie Wilson
Assistant Office Manager