



FALL CREEK REGIONAL WASTE DISTRICT

9378 S. 650 West PO Box 59
Pendleton, IN 46064-0059 778-7544

add order
on file

26-00210.00

APPLICATION FOR SEWER PERMIT

Nº 2852

Date 7-26-2000

Permit Void 90 days from Date of Issuance

Owner Name Jerry Fillburn

Property Address 7375 S 600W

Lot # _____ P.O. Box _____

Town Pendleton, IN Zip Code 46064

Phone _____ City Water _____ Well ☒

\$ 2556.00 Tap on Fee Paid and paid for grinder unit

\$ _____ Inspection fee paid _____

Application is hereby made for connection to the Fall Creek Regional Waste District Sewer System for the above listed property - Permit Type: Residential ☒, Commercial _____, Industrial _____, or Governmental/Institutional _____. User Information _____.

All workmanship and materials shall conform to the standards of the District Ordinance as described in Ordinance 84-2 and 84-3 as amended. Acceptance and approval must be made by the District inspector or his duly authorized representative before backfilling and final connection is made to the main sewer lines. Any violation of applicable regulations will cause all lines and appurtenances in violation to be removed and replaced at the owners expense.

The Fall Creek Regional Waste District is responsible for the inspection, approval of materials, and installation techniques only. All costs for materials and installation and any liabilities resulting from same is the sole responsibility of the property owner.

I have read and fully understand the above provisions and agree to comply by said provisions.

Jerry L. Fillburn
APPLICANT(S) SIGNATURE

INSPECTOR TIM

Date inspected 9-25-00 Approved ☒ Rejected _____

Reason for rejection _____

Date reinspected _____ Approved _____ Rejected _____

Notes:

Size Pipe 4"

Type Pipe SOL 35

Basement Yes ☒ No _____

Sump Pump Yes ☒ No _____

Downspout to Ground Yes ☒ No _____


Septic Tank Pumped & filled Yes ☒ No _____

Contractor SELF

Special Conditions _____

Existing Home ☒

New Construction _____

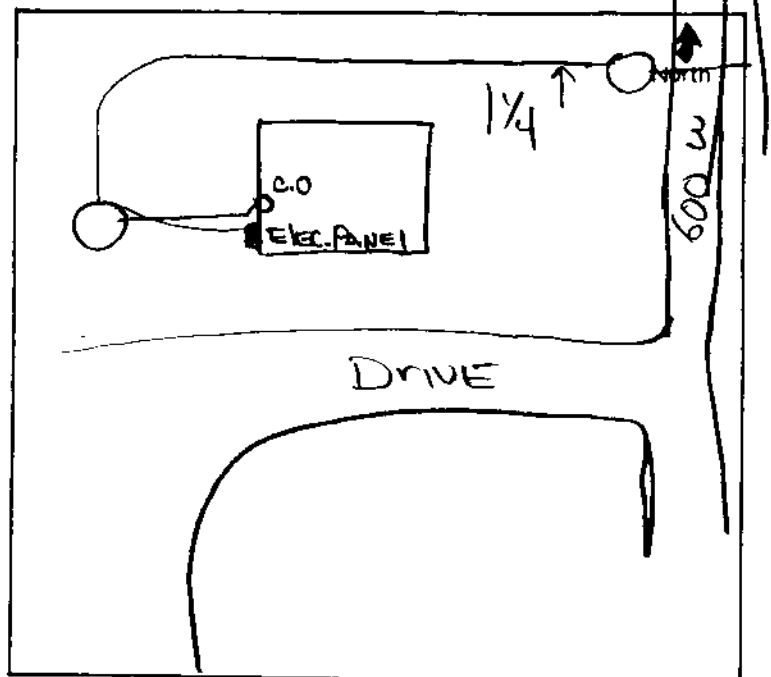

Fax: 765-778-7545

Amount Due	\$2,200.45
-------------------	-------------------

DAILY SUMMARY

CMD7-END

Account No. 260021000 FILBURN, TERRY

7375 S 600 W

Sel	Date	Tran Type	Total	Waste Wtr	Penalty
-----	------	-----------	-------	-----------	---------

	3/25/99	BILLING	27.35	27.35	
	4/22/99	PAYMENT	27.35	27.35	
	4/26/99	BILLING	27.35	27.35	
	5/24/99	PAYMENT	27.35	27.35	
	5/26/99	BILLING	27.35	27.35	
	6/21/99	PAYMENT	27.35	27.35	
	6/25/99	BILLING	27.35	27.35	
	7/26/99	BILLING	54.70	54.70	
	8/04/99	PAYMENT	54.70	54.70	
	8/27/99	BILLING	27.35	27.35	
	9/15/99	PAYMENT	27.35	27.35	
	9/24/99	BILLING	27.35	27.35	
	10/22/99	PAYMENT	27.35	27.35	
	10/25/99	BILLING	54.70	54.70	
	10/28/99	PAYMENT	27.35	27.35	

~~Due \$328.70 thru 3-16-00~~

DAILY SUMMARY

CMD7-END

Account No 260021000 FILBURN, TERRY 7375 S 600 W

Sel	Date	Tran Type	Total	Waste Wtr	Penalty
	11/24/99	BILLING	27.35	27.35	
	12/17/99	PAYMENT	27.35	27.35	
	12/23/99	BILLING	27.35	27.35	
	1/24/00	BILLING	54.70	54.70	
	1/25/00	PAYMENT	26.78	26.78	
	2/17/00	BILL ADJ	.01	.01	
	2/25/00	BILLING	55.27	55.27	
	3/16/00	PAYMENT	55.27	55.27	
	3/24/00	BILLING	27.35	27.35	
	4/24/00	PAYMENT	27.35	27.35	
	4/26/00	BILLING	27.35	27.35	