

Gidw.


PROJECT Phase II SHEET _____ OF _____

SUBJECT _____ DATE 4-27-18

JOB NO. 4447

BY Atlas

737 S. Broadway

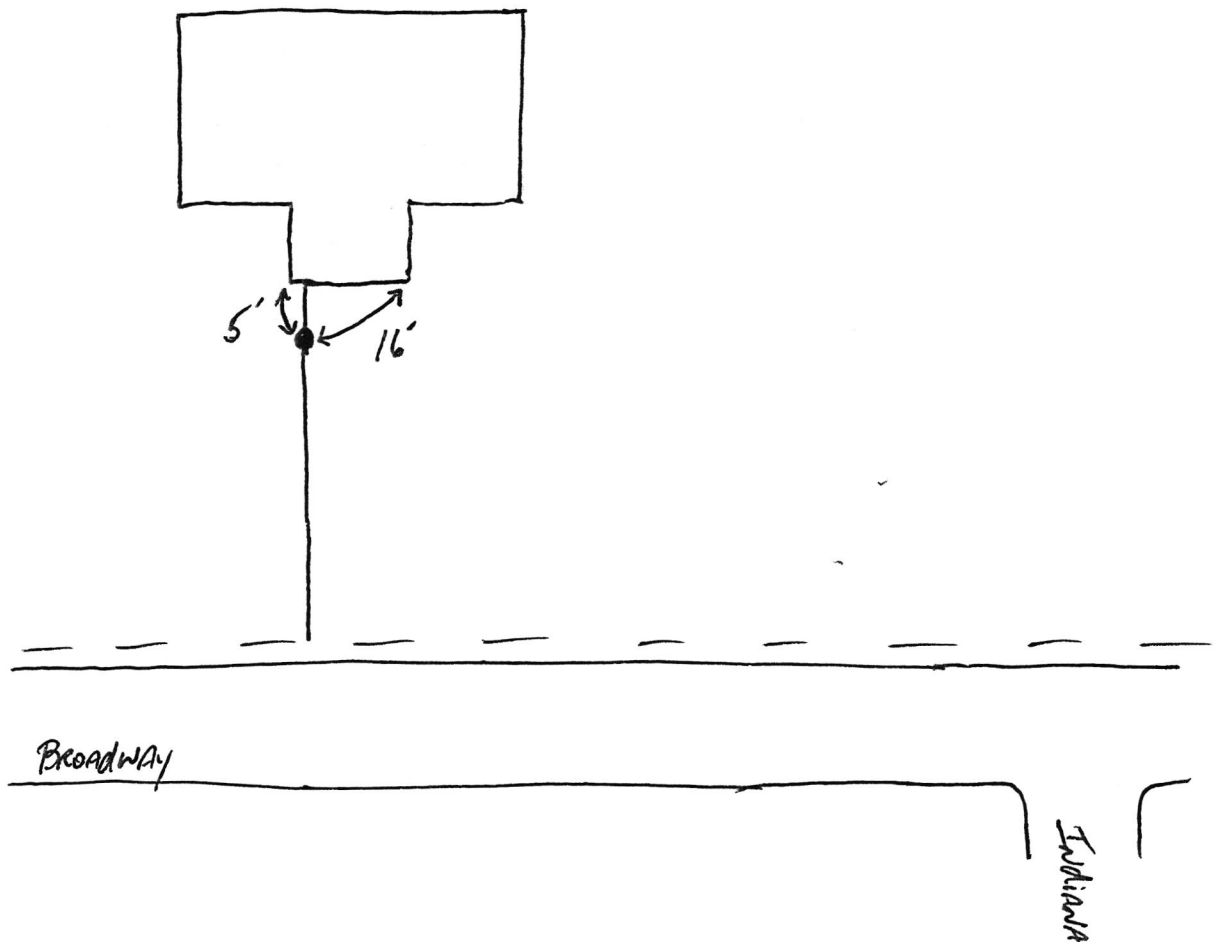

737 S Broadway

SRP
Phase II

5-3-18

