



FALL CREEK REGIONAL WASTE DISTRICT

Box 44, Pendleton, Indiana 46064

WORK TO BE
DONE BY MID SEPT

1-0000065

No 001586

APPLICATION FOR SEWER PERMIT

Permit No. _____ Date 8-25-86

Permit Void 90 days from Date of Issuance

Owner Name ROBERT L. HEAD.

Property Address 741 N. EAST STREET

Lot # _____ P.O. Box _____

Town INGALLS, IN Zip Code _____

Phone _____ Water Meter 5/8"

\$ 1,500.00 Tap on Fee Paid

\$ 25.00 Inspection fee paid

Application is hereby made for connection to the Fall Creek Regional Waste District Sewer System for the above listed property - Permit Type: Residential X, Commercial _____, Industrial _____, or Governmental/Institutional _____. User Information _____.

All workmanship and materials shall conform to the standards of the District Ordinance as described in Ordinance 84-2 and 84-3 as amended. Acceptance and approval must be made by the District inspector or his duly authorized representative before backfilling and final connection is made to the main sewer lines. Any violation of applicable regulations will cause all lines and appurtenances in violation to be removed and replaced at the owners expense.

The Fall Creek Regional Waste District is responsible for the inspection, approval of materials, and installation techniques only. All costs for materials and installation and any liabilities resulting from same is the sole responsibility of the property owner.

I have read and fully understand the above provisions and agree to comply by said provisions.

Robert L. Head
APPLICANT(S) SIGNATURE

INSPECTOR B

Date inspected ? Approved ✓ Rejected _____

Reason for rejection _____

Date reinspected _____ Approved _____ Rejected _____

Notes:

Size Pipe 6"

Type Pipe PVC

Basement Yes _____ No X


Sump Pump Yes _____ No X

Downspout to Ground Yes X No _____

Septic Tank Pumped & filled Yes NO

Contractor HARRY COZART

Special Conditions _____

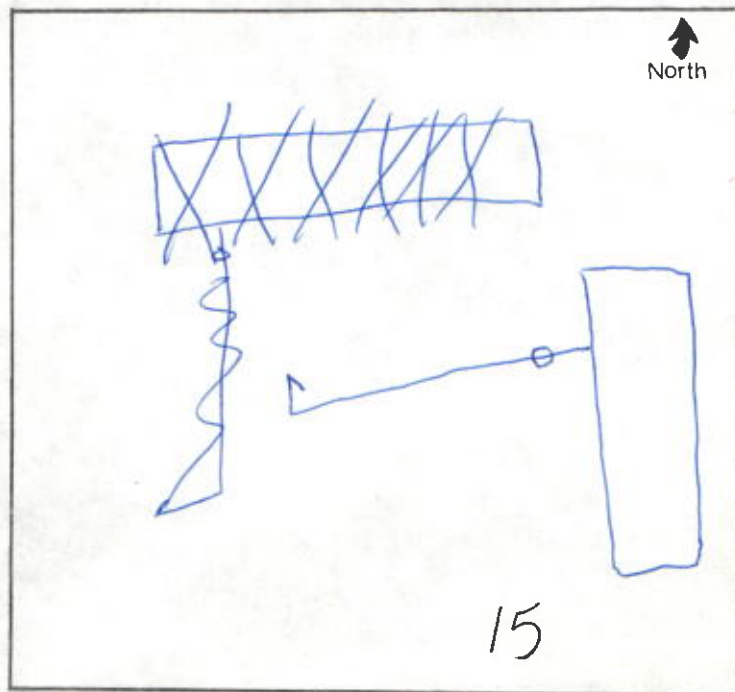

Work to be done by Mid Sept

FALL CREEK REGIONAL WASTE DISTRICT

Box 25, Goodwin, Idaho 83002



NA 001288

8-22-80

Robert L. Head
JH
EAST STREET

IN WALLS

2/8"

1,200.00

5.00

X

Robert L. Head

