



FALL CREEK REGIONAL WASTE DISTRICT

Box 44, Pendleton, Indiana 46064

1:00
or
1:30

2-0019720.00

Nº 001414

APPLICATION FOR SEWER PERMIT

Permit No. _____ Date March 17, 1986
Permit Void 90 days from Date of Issuance
Owner Name James Addison
Property Address 7424 Sprague
Lot # _____ P.O. Box _____
Town Anderson, IN Zip Code 46013
Phone 644-4266 Water Meter _____
\$ 150.00 Tap on Fee Paid
\$ 25.00 Inspection fee paid

Application is hereby made for connection to the Fall Creek Regional Waste District Sewer System for the above listed property - Permit Type: Residential ☒, Commercial _____, Industrial _____, or Governmental/Institutional _____. User Information _____.

All workmanship and materials shall conform to the standards of the District Ordinance as described in Ordinance 84-2 and 84-3 as amended. Acceptance and approval must be made by the District inspector or his duly authorized representative before backfilling and final connection is made to the main sewer lines. Any violation of applicable regulations will cause all lines and appurtenances in violation to be removed and replaced at the owners expense.

The Fall Creek Regional Waste District is responsible for the inspection, approval of materials, and installation techniques only. All costs for materials and installation and any liabilities resulting from same is the sole responsibility of the property owner.

I have read and fully understand the above provisions and agree to comply by said provisions.

APPLICANT(S) SIGNATURE

INSPECTOR [Signature]


Date inspected 3-24 Approved _____ Rejected _____

Reason for rejection _____

Date reinspected _____ Approved _____ Rejected _____

Notes:

Size Pipe 6 "
Type Pipe PVC
Basement Yes _____ No ☒
Sump Pump Yes _____ No ☒
Downspout to Ground Yes ☒ No _____
Septic Tank Pumped & filled Yes _____ No ☒
Contractor Addison
Special Conditions S.I.T. SERVING
EXISTING TRAILER

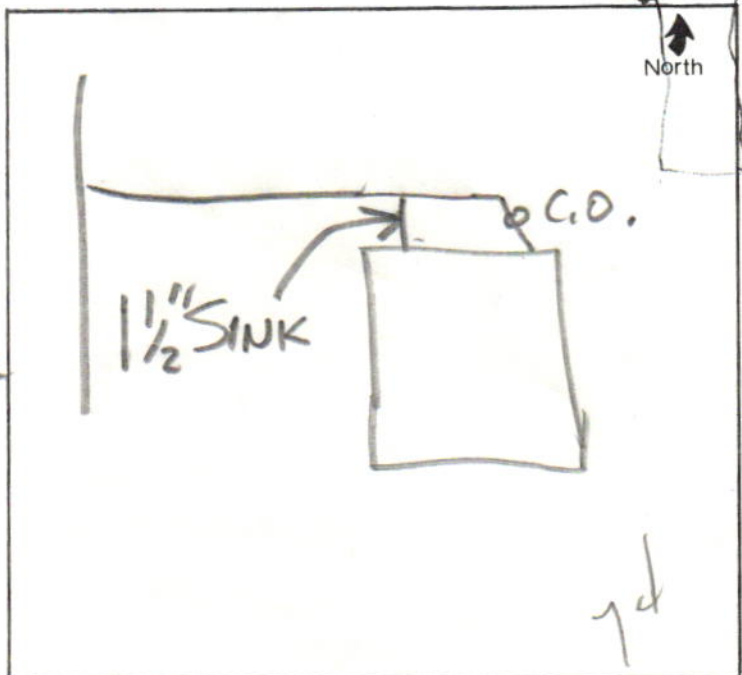

22-19722.00

April 96



FALL CREEK REGIONAL WASTE DISTRICT

9378 S. 650 West PO Box 59
Pendleton, IN 46064-0059 778-7544

Nº 2343

APPLICATION FOR SEWER PERMIT

Date _____

Permit Void 90 days from Date of Issuance

Owner Name Jim Addison

Property Address 7424 1/2 Sprague

Lot # _____ P.O. Box _____

Town _____, IN Zip Code _____

Phone _____ City Water _____ Well _____

\$ N/A Tap on Fee Paid

\$ 2156 capacity inspection fee paid pd 10/8/98

Application is hereby made for connection to the Fall Creek Regional Waste District Sewer System for the above listed property - Permit Type: Residential _____, Commercial _____, Industrial _____, or Governmental/Institutional _____. User Information _____.

All workmanship and materials shall conform to the standards of the District Ordinance as described in Ordinance 84-2 and 84-3 as amended. Acceptance and approval must be made by the District inspector or his duly authorized representative before backfilling and final connection is made to the main sewer lines. Any violation of applicable regulations will cause all lines and appurtenances in violation to be removed and replaced at the owners expense.

The Fall Creek Regional Waste District is responsible for the inspection, approval of materials, and installation techniques only. All costs for materials and installation and any liabilities resulting from same is the sole responsibility of the property owner.

I have read and fully understand the above provisions and agree to comply by said provisions.

APPLICANT(S) SIGNATURE _____

INSPECTOR [Signature]


Date inspected 3-26-96 Approved [initials] Rejected ✓

Reason for rejection Job WAS NEVER INSPECTED
By FCRWD MAINTENANCE

Date reinspected _____ Approved _____ Rejected _____

Notes:
Size Pipe 6 "
Type Pipe PVC
Basement Yes ✓ No ✓
Sump Pump Yes ✓ No ✓
Downspout to Ground Yes ✓ No ✓
Septic Tank Pumped & filled Yes ✓ No ✓
Contractor Jim Addison
Special Conditions _____

Existing Home _____
New Construction TRAILER

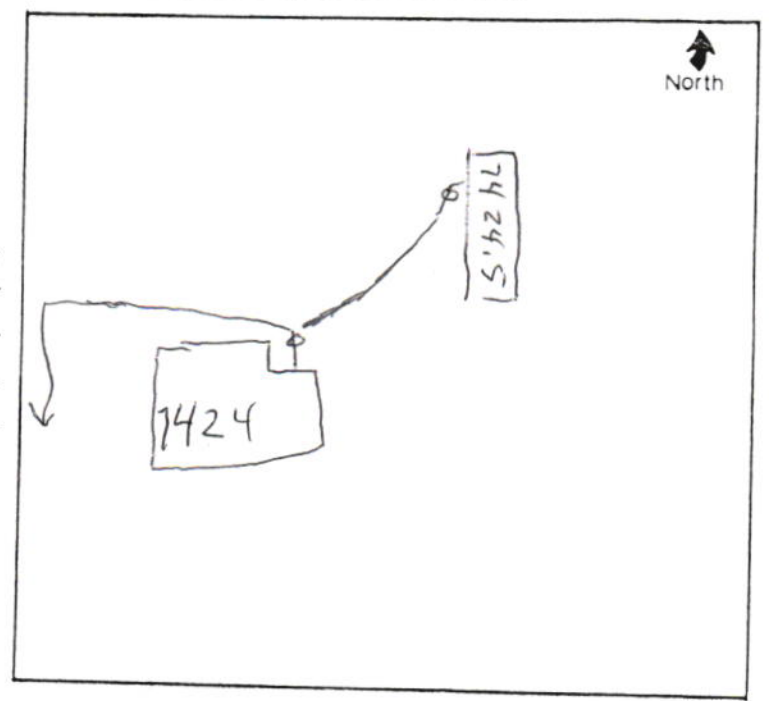

James
7424 1/2 Sprague
Bill
Shirley Addison
7316 Sprague
46013

COMER OUT

CODE:

OWNER
SOLD

RENTER
RENTED

PHONE NO:

FINAL SENT DATE:
N OF FINAL BILL

OTHER INFORMATION:

ACCOUNT NUMBER : 22-19722.00 CUSTOMER IN
CUSTOMER NAME : Shirley Addison CODE: 3
SS#(S) : OWNER RENTER
SERVICE ADDRESS : 7424 1/2 Sprague
Anderson, In 46013 PHONE NO:
MAILING ADDRESS : 7316 Sprague
Anderson, In 46013-3941
(IF DIFFERENT THAN ABOVE)
IN DATE : ADMIN LETTER SENT:
CALCULATIONS : 2/16/96 TO 3/16/96 OVERRIDE AMOUNT:
MONTH ADDED : April 96 MINIMUM AMOUNT: 30.76
OTHER INFO :

7424 = 22-19720.00

A & A BACKHOE SERVICES

JAMES ADDISON

7316 SPRAGUE ST PH 640-0310
ANDERSON, IN 46013



7646

71-167749
BRANCH 10002


DATE 10-10-98

PAY
TO THE
ORDER OF

Fall Creek Regional Waste Dist

\$ 2,165.00

Two Thousand One hundred Sixty five — ⁰⁰/₁₀₀

DOLLARS  Security features included. Details on back.



7424 1/2

"Hoosier Owned & Hoosier Proud"

FOR

Paid the Second Time

Shirley A Addison

⑈007646⑈