



FALL CREEK REGIONAL WASTE DISTRICT

9378 S. 650 West PO Box 59
Pendleton, IN 46064-0059 778-7544

add order

22-15216.00 on file

APPLICATION FOR SEWER PERMIT

Nº 2200

Date 5/26/95

Permit Void 90 days from Date of Issuance

Owner Name Bluebird Realty Kevin Landrum

Property Address 7427 Colonial Court

Lot # 75 P.O. Box _____

Town Anderson, IN Zip Code 46013

Phone _____ City Water _____ Well ☒

\$ 2700.00 Tap on Fee Paid

\$ 25.00 Inspection fee paid

Application is hereby made for connection to the Fall Creek Regional Waste District Sewer System for the above listed property - Permit Type: Residential ☒, Commercial _____, Industrial _____, or Governmental/Institutional _____. User Information _____.

All workmanship and materials shall conform to the standards of the District Ordinance as described in Ordinance 84-2 and 84-3 as amended. Acceptance and approval must be made by the District inspector or his duly authorized representative before backfilling and final connection is made to the main sewer lines. Any violation of applicable regulations will cause all lines and appurtenances in violation to be removed and replaced at the owners expense.

The Fall Creek Regional Waste District is responsible for the inspection, approval of materials, and installation techniques only. All costs for materials and installation and any liabilities resulting from same is the sole responsibility of the property owner.

I have read and fully understand the above provisions and agree to comply by said provisions.

[Signature]

APPLICANT(S) SIGNATURE

INSPECTOR Tim

Date inspected 6-5-95 Approved ☒ Rejected _____

Reason for rejection _____

Date reinspected _____ Approved _____ Rejected _____

Notes:

Size Pipe 6"

Type Pipe SDR 35

Basement Yes _____ No ☒

Sump Pump Yes _____ No ☒

Downspout to Ground Yes ☒ No _____


Septic Tank Pumped & filled Yes _____ No _____

Contractor DAVIS Construction

Special Conditions _____

Existing Home _____

New Construction ☒

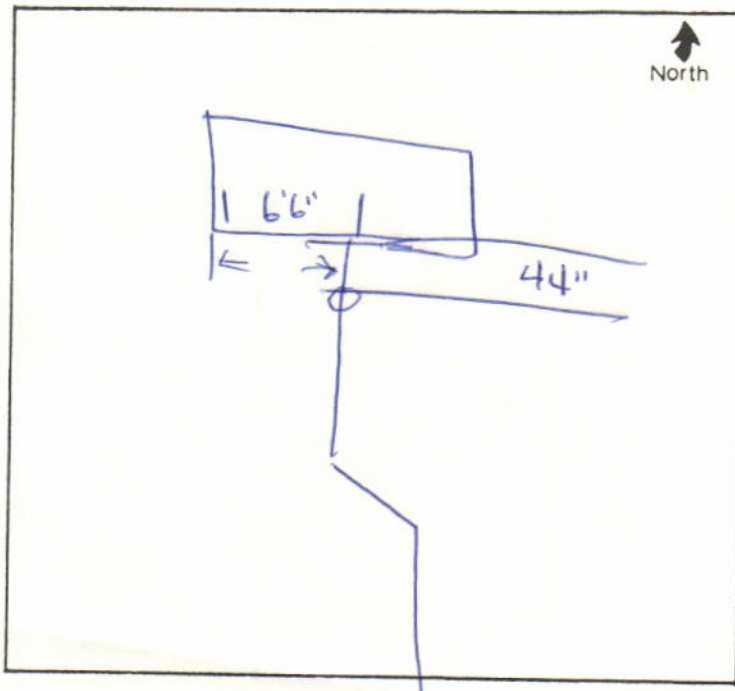



BOX 39, 103 SOUTH MAPLE STREET
SULPHUR SPRINGS, INDIANA 47388

PH. (317) 533-4747 • FAX (317) 533-4750

DATE	INVOICE	AMOUNT

2741

71-830
749

PAY Twenty Seven Twenty Five ⁰⁰/₁₀₀

TIME WK D	DATE	TO THE ORDER OF	GROSS AMOUNT	INCOME TAX	SOC SEC	STATE TAX	CO TAX	DOLLARS	NET AMOUNT
	5-26-95	FCRWD							2725 ⁰⁰

Sewer Hookup #75

FIRST UNITED BANK
SULPHUR SPRINGS, INDIANA 47388

Mary Ellen Jones

⑈002741⑈ ⑆074908303⑆